

SURVEY & REMONUMENTATION

APR 29 1996

COMMISSION

LAND CORNER RECORDATION CERTIFICATE

Filing Requirement of Act 74, Mich. P.A. 1970


JUDITH D. ROEHM
 Ontonagon County
 LC 4/ 8 JEM Feet 9.00
 12/18/95
 15:01
 Page 1 of 1

For corners in ONTONAGON Located In: Corner Code #
 (County)

- | | | | | | |
|--------------------------------------|---|----|---|----|-----|
| 1. Public Land Survey | T | 51 | R | 39 | C-3 |
| | T | | R | | |
| | T | | R | | |
| | T | | R | | |
| 2. Property Controlling in Section | S | | T | | R |
| | S | | T | | R |
| 3. Miscellaneous Property in Section | S | | T | | R |
| | S | | T | | R |

Register of Deeds Stamp & File Number

4. Lot No. _____, Recorded Plat _____
 5. Private Claims _____

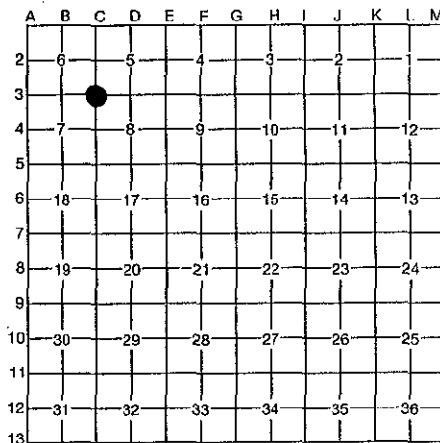

Section Corner common to Sections 5, 6, 7 & 8, T51N R39W.

I, Earl W. Applekamp, in a field survey on September 21, 19 95, do hereby certify that under requirements of P.A. 74, Michigan P.A. of 1970, the corner points mentioned in lines 1 and 2 above were in conformance with regulations and rules therefore as required in the current manual of survey instructions of the United States Department of the Interior, Bureau of Land Management or by a decree of a Court of Law and/or that the corner points mentioned in lines 3, 4 and 5 above were in conformance with the rules of the Michigan Board of Professional Surveyors or by a Decree of a Court of Law; established, re-established, monumented, re-monumented, recovered, found as expressed below:

NOTE: Not more than 4 corners, all in the same town and range, may be recorded on this certificate.

A. Description of original monument and accessories and/or subsequent restoration:

Original corner established by Austin Burt, U.S. Deputy Surveyor, August 1845. Set Maple Post.

ORIGINAL BEARING TREES:

- | | | | | |
|---------|-----|-------|----------|--------------|
| Hemlock | 30" | S60°W | 3 links | (1.98 feet) |
| Hemlock | 12" | N61°E | 43 links | (28.38 feet) |

B. Description of corner evidence found and/or method applied in restoring or reestablishing corner:

On a Michigan Highway drawing, dated 1948, for US-45, there is shown a 1" Iron Pin a distance of 1738.63 feet from the centerline of the highway along a gravel Township road. I did not find the iron pin but found the fence post to the North which was used for one of the ties. The fence continues to the North. I accepted the corner location because of the evidence found and its consistency with the original G.L.O. notes. I monumented the corner as described in "C" below.

Research on file.


PEER GROUP APPROVED

Earl W. Applekamp 12-14-95
 COUNTY REPRESENTATIVE

C. Description of monument for corner and accessories established to perpetuate locating the position of the corner:

At the corner position I set a 1/2"x12" I.P. with a 3/4" aluminum cap in the center of the road, 4" below the gravel surface. The cap is stamped to read COUNTY REMONUMENTATION, T51N R39W, S5, S6, S7, S8, 1995, P.S. 17610. I established the following bearing trees, reference objects and witness corner.

- | | | | | | | |
|----------|-------|------------|---|--|-------|------------------|
| 3" Maple | N34°E | 34.82 feet | - | REA Power Pole | N68°W | 77.72 feet |
| 4" Aspen | S08°W | 31.34 feet | - | 2 1/2"x30" aluminum pipe with a stamped 3/4" cap | W.C. | North 25.07 feet |

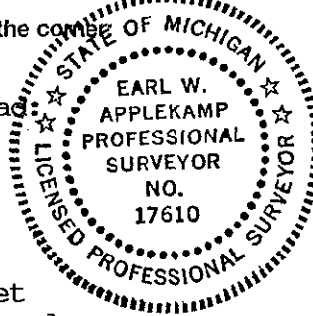

Signed by Earl W. Applekamp
 Surveyor's Michigan License No. 17610

Date September 22, 1995