

21112

1997 PRESQUE ISLE COUNTY STATE OF MICHIGAN REMONUMENTATION

LAND CORNER RECORDATION CERTIFICATE
Filing Requirement of Act 74, Mich. P.A. 1970

LIBER 325 PAGE 099

For corners in

Presque Isle (County)	Located In:	Corner Code #
	Belknap Twp.	
1. Public Land Survey	T 34N R 5E	1 7
	T R	
	T R	
	T R	
	T R	
2. Property Controlling in Section	S T R	
	S T R	
3. Miscellaneous Property in Sec.	S T R	
	S T R	

PRESQUE ISLE COUNTY
RECORDED

97 DEC 18 AM 9:56

Janet M. Lamb
REGISTER OF DEEDS

Register of Deeds Stamp & File Number

4. Lot No. _____, Recorded Plat _____
5. Private Claims _____

I, James A. Beck, in a field survey on Oct. 30, 1997 do hereby state that under requirements of P.A. 74, Michigan P.A. of 1970, the corner points mentioned in lines 1 and 2 above were in conformance with regulations and rules therefore as required in the current manual of survey instructions of the United States Department of the Interior, Bureau of Land Management or by a decree of a Court of Law and/or that the corner points mentioned in lines 3, 4 and 5 above were in conformance with the rules of the Michigan Board of Land Surveyors or by a Decree of a Court of Law, established, re-established, monumented, recovered, found as expressed below:

NOTE: Not more than 2 corners, all in the same town and range, may be recorded on this certificate.

	A	B	C	D	E	F	G	H	I	J	K	L	M
1													
2	6	5	4	3	2	1							
3													
4	7	8	9	10	11	12							
5													
6	18	17	16	15	14	13							
7													
8	19	20	21	22	23	24							
9													
10	30	29	28	27	26	25							
11													
12	31	32	33	34	35	36							
13													

A. Description of original monument and accessories and/or subsequent restoration:

17 1856 G.L.O. by Alfred Miller
"Set post Cor. Secs 14, 15, 22 & 23"
Beech 12 S2
Beech 10 N45W 9

Aug. 25, 1978 P.A. 74 (Land Corner Recordation) Certificate
page 312 by Ronald R. Bischer Reg. No. 22428

Part A. No entry
Part B. Found 2" pipe buried 3 1/2'
deep, raised with 1/2" rod, set Mon. Box
Part C. " 1/2" Rod in Mon. Box
N07°W 90.29' Stop Sign; S51°E 132.98' P. Pole

B. Description of corner evidence found and/or method applied in restoring or reestablishing corner:

17 Found 1/2" iron and R.L.S. 15410 cap
Accessories:
S 51°E 132.8 ft., R.L.S. 15410 (Delmer Porter) tag in power pole

SURVEY &
REMONUMENTATION


JAN 14 1998

Ratified by Peer Group
in accordance with P.A. 345

Chairman *Norman J. ...*
Date 11/13/97

C. Description of monument for corner and accessories established to perpetuate locating the position of the corner:

17 1/2" iron and R.L.S. 15410 cap
Accessories:
S 51°E 132.8 ft., R.L.S. 15410 (Delmer Porter) tag in power pole
S 6°W 30.20 ft., P.S. 21559 tag in 8" Elm
S 48°W 47.17 ft., P.S. 21559 tag in 10" Poplar
N 13°W 77.3 ft., stop sign post
Corner falls at center of blacktop roads North, and East-West 4E 20

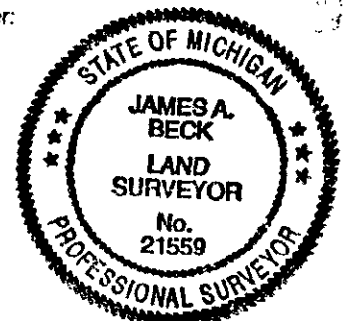

Signed by *James A. Beck*
Surveyor's Michigan License No. 21559

Date 12/8/1997