

For corners in

<u>Presque Isle</u> (County)	Located In:	Corner Code #
1. Public Land Survey	T34N R 5E	M-10
	T R	
	T R	
	T R	
2. Property Controlling in Section	S T R	
	S T R	
3. Miscellaneous Property in Sec.	S T R	
	S T R	

*Janet M. Stambaugh*  
REGISTER OF DEEDS  
**SURVEY &  
REMONUMENTATION**  
**JAN 14 1998**  
**SECTION**  
Register of Deeds Stamp & File Number

4. Lot No. \_\_\_\_\_, Recorded Plat \_\_\_\_\_  
5. Private Claims \_\_\_\_\_

I, Delmer E. Porter in a field survey on 3-27, 1997 do hereby state that under requirements of P.A. 74, Michigan P.A. of 1970, the corner points mentioned in lines 1 and 2 above were in conformance with regulations and rules therefore as required in the current manual of survey instructions of the United States Department of the Interior, Bureau of Land Management or by a decree of a Court of Law and/or that the corner points mentioned in lines 3, 4 and 5 above were in conformance with the rules of the Michigan Board of Land Surveyors or by a Decree of a Court of Law; established, re-established, monumented, recovered, found as expressed below:

NOTE: Not more than 2 corners, all in the same town and range, may be recorded on this certificate.

	A	B	C	D	E	F	G	H	I	J	K	L	M
1													
2	6		5		4		3		2		1		
3													
4	7		8		9		10		11		12		
5													
6	18		17		16		15		14		13		
7													
8	19		20		21		22		23		24		
9													
10	30		29		28		27		26		25		
11													
12	31		32		33		34		35		36		
13													

A. Description of original monument and accessories and/or subsequent restoration:

M-10  
GLO Notes Set Qr. Sec Post  
Alfred Millard Hemlock 20" N50° E 10 Lk  
July 5, 1856 Hemlock 12" S80° W 24 Lk  
Old Qr. Cor 100 Lks W &  
46 Lks N - effaced

R. Bischer #22428 Set 1/2" Rod by S.P.  
Act 74 Filing N43° W 35.81' 4" Map1  
Dec. 28, 1982 N80° W 44.92' 6" Map1  
L. 1 Pg. 593 S54° W 60.33' 8" Map1  
L. 1 Pg. 598 (Note: 20' West of  
Drainage ditch)

Note: L. 1 Pg 598 Rec. in T34N, R6E  
"Continued on Back"


B. Description of corner evidence found and/or method applied in restoring or reestablishing corner:

M-10  
Fd. 1/2" Rod & Cap #15410  
On W'ly Edge of Drain  
N33° W 35.93' 6" Maple  
N77° W 44.84' 8" Maple  
S71° W 23.45' 7" Lynn  
S31° W 55.97' 7" Maple

Ratified by Peer Group  
in accordance with P.A. 345  
Chairman *Norman J. Quinn*  
Date 12/04/97

C. Description of monument for corner and accessories established to perpetuate locating the position of the corner:

M-10  
1/2" Rod & Cap #15410  
On W'ly Edge of Drain  
N33° W 35.93' 6" Maple  
N77° W 44.84' 8" Maple  
S71° W 23.45' 7" Lynn  
S31° W 55.97' 7" Maple

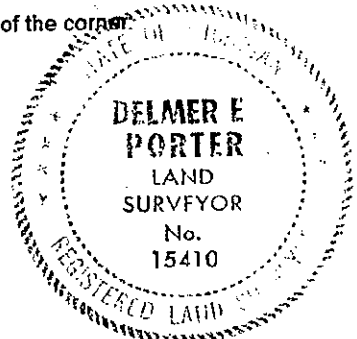

Signed by *Delmer E. Porter*  
Surveyor's Michigan License No. 15410

Date 12/18/97

## A Continued:

J. Beck, #21559  
Act 74 Filing  
Oct. 11, 1993  
L. 307 Pg. 302

Fd. 1/2" Rod & Porter's Survey Cap  
on W'ly edge of drain bank  
N43°W 35.81' 7" Maple  
N80°W 44.92' 8" Maple  
Left 1/2" Rod & Porter's Survey Cap  
on W'ly edge of drain bank  
N43°W 35.81' 7" Maple  
N80°W 44.92' 8" Maple  
S20°W 55.95' 6" Maple in Clump  
S60°W 23.40' 6" Deciduous Tree

J. Beck #21559  
Act 132 Survey  
Sept. 30, 1993  
Rec. Jan 13, 1994  
L. 308 Pg. 320

No mention of Corner  
N43°W 35.81' 4" Maple  
N80°W 44.92' 6" Maple  
S20°W 55.95' 6" Maple  
S60°W 23.40' 6" Deciduous