

PRESQUE ISLE COUNTY
 REGISTERED
 Janet M. Lamb
 REGISTER OF DEEDS

For corners in

Presque Isle (County)	Located In:	Corner Code #
1. Public Land Survey	T 34NR 5E	M-11
	T R	
	T R	
	T R	
2. Property Controlling in Section	S T R	
	S T R	
3. Miscellaneous Property in Sec.	S T R	
	S T R	

**SURVEY &
 REMONUMENTATION**

JAN 14 1998

Register of Deeds Stamp & File Number

4. Lot No. _____, Recorded Plat _____
 5. Private Claims _____

I, Delmer E. Porter in a field survey on 3-27, 1997 do hereby state that under requirements of P.A. 74, Michigan P.A. of 1970, the corner points mentioned in lines 1 and 2 above were in conformance with regulations and rules therefore as required in the current manual of survey instructions of the United States Department of the Interior, Bureau of Land Management or by a decree of a Court of Law and/or that the corner points mentioned in lines 3, 4 and 5 above were in conformance with the rules of the Michigan Board of Land Surveyors or by a Decree of a Court of Law, established, re-established, monumented, recovered, found as expressed below:

NOTE: Not more than 2 corners, all in the same town and range, may be recorded on this certificate.

	A	B	C	D	E	F	G	H	I	J	K	L	M
1													
2	6		5		4		3		2		1		
3													
4	7		8		9		10		11		12		
5													
6	10		17		16		15		14		13		
7													
8	19		20		21		22		23		24		
9													
10	30		29		28		27		26		25		
11													
12	31		32		33		34		35		36		
13													

A. Description of original monument and accessories and/or subsequent restoration:

M-11		R. Bischer #22428	Fd. 1/2" Rod
GLO Notes	Set Post Cor of Sec 25&36	Act 74 Filing	N23°W 75.91' P. Pole
Alfred Millard	Sugar 12" N30°W 30 Lk	Dec. 20, 1982	S49°E 57.90' Tele
July 5, 1856	Beech 14" S42°W 41 Lk	L. 1 Pg. 597	Cable Box
			S10°E 79.00' Stop
			Sign

"Continued on Back"

B. Description of corner evidence found and/or method applied in restoring or reestablishing corner:


M-11
 Fd. 1/2" Rod
 Put Cap #33984 On
 @ Rd. C/L - C/L Int.
 Fd. Road Sign, Stop Sign, and Tele Cable Box
 Witnesses - all were in very poor condition
 N21°W 75.88' P. Pole
 N05°W 116.79' 6" Apple

Ratified by Peer Group
 in accordance with P.A. 345

Chairman Norman [Signature]
 Date 12/04/97

C. Description of monument for corner and accessories established to perpetuate locating the position of the corner:

M-11
 1/2" Rod & Cap #33984 @ Rd. C/L - C/L Int.
 N21°W 75.88' P. Pole
 N05°W 116.79' 6" Apple
 N18°W 79.16' 8" Apple
 S02°E 243.24' 21" Elm

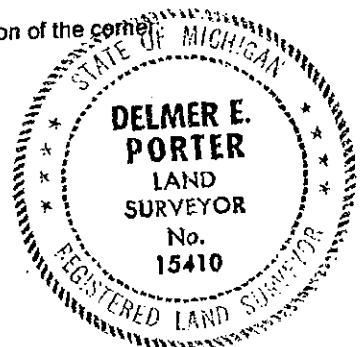

Signed by Delmer E. Porter
 Surveyor's Michigan License No. 15410

Date 12/18/97

A Continued:

R. Bischer #22428	Fd. 1/2" Rod
Act 74 Filing	N23°W 75.91' P. Pole
Dec. 28, 1982	S49°E 57.90' Tele Cable Box
L. 1 Pg. 594	S10°E 79.00' Stop Sign
J. Beck, #21559	Fd. 1/2" Rod & Porter's Survey Cap
Act 74 Filing	N23°W 75.91' P. Pole
Oct. 11, 1993	S49°E 57.90' Tele Cable Box
Pg. 866	S10°E 79.00' Stop Sign
L. 307 Pg. 302	Left 1/2" Rod & Porter's Survey Cap
	N23°W 75.91' P. Pole
	S49°E 57.90' Tele Cable Box
	S10°E 79.00' Stop Sign
	S25°E 61.6' Road Sign
J. Beck, #21559	No mention of Corner
Act 132 Survey	N23°W 75.91' P. Pole
Sept. 30, 1993	S49°E 57.90' Tele Cable Box
Rec: Jan. 13, 1994	S10°E 79.00' Stop Sign
L. 308 Pg. 320	S25°E 61.60' St. Sign