

LAND CORNER RECORDATION CERTIFICATE

Filing Requirement of Act 74, Mich. PA 1970

For Corners In:
Roscommon Located In _____ Corner Code # _____
 (County)

1. Public Land Survey	T _____	R _____		
	T _____	R _____		
2. Property Controlling in Section	S <u>10</u>	T <u>24N</u>	R <u>4W</u>	<u>8</u>
	S <u>10</u>	T <u>24N</u>	R <u>4W</u>	<u>15</u>
3. Miscellaneous Property in Section	S _____	T _____	R _____	
	S _____	T _____	R _____	


4. Lot No: _____ Recorded Plat: _____

5. Private Claims: _____

I, Carl T. Kiiskila, in a field survey on September 23, 2003 do hereby state that under requirements of PA 74, Michigan PA of 1970, the corner points mentioned in lines 1 and 2 above were in conformance with regulations and rules therefore as required in the current manual of survey instructions of the United States Department of the Interior, Bureau of Land Management or by a decree of a Court of Law and/or that the corner points mentioned in lines 3, 4 and 5 above were in conformance with the rules of the Michigan Board of Land Surveyors or by a Decree of a Court of Law; established, re-established, monumented, recovered, found as expressed below:

NOTE: Not more than 2 corners, all in the same town and range, may be recorded on this certificate.

Register of Deeds Stamp & File Number

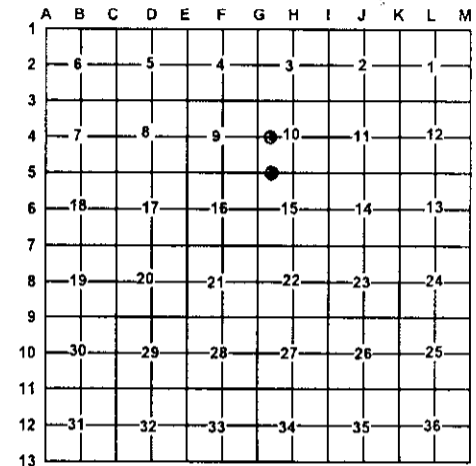

A. Description of original monument and accessories and/or subsequent restoration:

8- Kenneth J. Ostling 1979 set 5/8" iron bar with R.L.S. cap #10068 by standard survey procedure for the subdivision of section.	15- George D. Hennings P.S. #2240 set 1/2" bar No witnesses available.
	Frank J. Arleth P.S. # 21266 1993 found 1/2" bar Wit: sp 8" W. Oak N38°E 50.8' sp 12" W. Pine S17°E 30.8' sp 12" Maple N06°W 44.45'

B. Description of corner evidence found and/or method applies in restoring or re-establishing corner:

8- Found 5/8" capped iron rod R.L.S. #10068.	15- Found 1/2" iron rod, added P.S. cap #33981
--	--

C. Description of monument for corner and accessories established to perpetuate locating the position of the corner:

8- 5/8" iron rod with R.L.S. cap #10068 Wit: 16" Oak N47°E 46.45' 22" Oak N14°E 15.86' 22" Oak S40°W 24.23' 5" Maple S50°E 55.84' Orange Carsonite post South 1'±	15- 1/2" iron bar with P.S. Cap #33981 Wit: 10" W. Pine S24°E 38.78' 8" Oak S47°W 39.91' 8" Oak N49°E 50.57' 10" Twin Oak N50°W 57.94'
--	--

Signed by: Carl T. Kiiskila
 Surveyor's Michigan License No.: 33981

Date: 10-8-03

