

ST. CLAIR COUNTY, MICHIGAN OFFICIAL GOVERNMENT CORNER



LAND CORNER RECORDATION CERTIFICATE Filing Requirement of Act 74, Mich. P.A. 1970

	Located In:	Corner Code #
1. Public Land Survey	T <u>7N.</u> R <u>R15E.</u>	D-13
	T _____ R _____	_____
	T _____ R _____	_____
	T _____ R _____	_____
2. Property Controlling in Section	S _____ T _____ R _____	<i>Seg. 2</i>
	S _____ T _____ R _____	
	S _____ T _____ R _____	
3. Miscellaneous Property in Sec.	S _____ T _____ R _____	_____

RECEIVED
REGISTER OF DEEDS
ST. CLAIR COUNTY
1995 AUG -4 AM 10:15
Register of Deeds Stamp & File Number

4. Lot No. _____, Recorded Plat _____
5. Private Claims _____

	A	B	C	D	E	F	G	H	I	J	K	L	M
2	6	5	4	3	2	1							
3													
4	7	8	9	10	11	12							
5													
6	18	17	16	15	14	13							
7													
8	19	20	21	22	23	24							
9													
10	30	29	28	27	26	25							
11													
12	31	32	33	34	35	36							
13													

I, Daniel E. Johnson, in a field survey on May 26, 1995, do hereby certify that under requirements of P.A. 74, Michigan P.A. of 1970, the corner points mentioned in lines 1 and 2 above were in conformance with regulations and rules therefore as required in the current manual of survey instructions of the United States Department of the Interior, Bureau of Land Management or by a decree of a Court of Law and/or that the corner points mentioned in lines 3, 4 and 5 above were in conformance with the rules of the Michigan Board of Land Surveyors or by a Decree of a Court of Law, established, re-established, monumented, re-monumented, recovered, found as expressed below:

NOTE: Not more than 1 corner, may be recorded on this certificate.

A. Description of original monument and accessories and/or subsequent restoration:

LIBER 007 PAGE 173


STATE PLAIN COORDINATES

N. _____

E. _____

B. Description of corner evidence found and/or method applied in restoring or reestablishing corner:

LIBER 007 PAGE 173

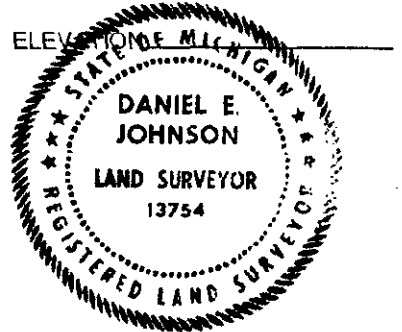

C. Description of monument for corner and accessories established to perpetuate locating the position of the corner:

Set with 2" dia. aluminum cap inscribed "St. Clair County Official Corner" with magnet
ON A
Iron Rod with cap stamped 24615.

NE 16.16' to set PK and County Tag in S face of 4" Birch
NE 105.60' to set PK and County Tag in NW face of telephone pole
NW 44.65' to set PK and County Tag in S face of telephone pole
NE 37.00' to set PK and County Tag in W face of railroad tie fence post
Southerly at right angle to the centerline of railroad tracks 23.13'

Signed by *Daniel E. Johnson* Date May 26, 1995
Daniel E. Johnson
13754
 Surveyor's Michigan License No. _____

PA 345-1990
PEER COMMITTEE

APPROVED AS AN OFFICIAL GOVERNMENT CORNER BY ST. CLAIR COUNTY:

Signed By: *Daniel E. Johnson* Date 7/31/95
St. Clair County Land Surveyor Daniel E. Johnson
#13754
 Surveyor's Michigan License No. _____

APPROVED 12-14-93 *Daka*
LIBER 008 PAGE 110