

RC 1236

LAND CORNER RECORDATION CERTIFICATE
Filing Requirement of Act 74, Mich. P.A. 1970

LI 27015 PA 711

For corners in

Wayne (County) Located In: Corner Code #

1. Public Land Survey T 1 S. R 10 E. A-12
 T R
 T R
 T R

2. Property Controlling in Section S T R
 S T R

3. Miscellaneous Property in Sec. S T R
 S T R

4. Lot No. , Recorded Plat

5. Private Claims

Compliance with ACT 345, P.A. 1990
 APPROVED ON: 12-7-93
 WAYNE COUNTY REMONUMENTATION PEER GROUP COMMITTEE

Register of Deeds Stamp & File Number

RC 1236

I, William L. Roskelly, in a field survey on October 27, 1993, do hereby certify that under requirements of P.A. 74, Michigan P.A. of 1970, the corner points mentioned in lines 1 and 2 above were in conformance with regulations and rules therefore as required in the current manual of survey instructions of the United States Department of the Interior, Bureau of Land Management or by a decree of a Court of Law and/or that the corner points mentioned in lines 3, 4 and 5 above were in conformance with the rules of the Michigan Board of Land Surveyors or by a Decree of a Court of Law; established, re-established, monumented, re-monumented, recovered, found as expressed below:

NOTE: Not more than 4 corners, all in the same town and range, may be recorded on this certificate.

	A	B	C	D	E	F	G	H	I	J	K	L	M
2	6		5		4		3		2		1		
3													
4	7		8		9		10		11		12		
5													
6	18		17		16		15		14		13		
7													
8	19		20		21		22		23		24		
9													
10	30		29		28		27		26		25		
11													
12	31		32		33		34		35		36		
13													

A. Description of original monument and accessories and/or subsequent restoration:

No G.L.O. witnesses remain
 L.C.R.C. L. 21061 P. 668 on Dec. 16, 1980 Grant J. Ward found a concrete monument in mon. box and set the following witnesses:
 N. 60° E. 58.69' PK nail in West side of Power Pole
 S. 25° E. 82.77' PK nail in S.W. side of Power Pole
 South 67.96' Concrete monument in Mon. Box
 S. 30° W. 102.15' PK nail in North side of Power Pole
 N. 85° W. 46.60' PK nail in South side of Power Pole

B. Description of corner evidence found and/or method applied in restoring or reestablishing corner:

Found iron pipe in concrete monument with mon. box at the intersection of Inkster and West Chicago Roads.

Also verified section corner thru document L. 21061, Pg. 668
 N. 60° E. 58.69 PK nail West side meas. 58.80
 S. 67.96 conc. mon. meas 67.92
 S. 30° W. 102.15 PK nail North side P. Pole meas. 102.20


C. Description of monument for corner and accessories established to perpetuate locating the position of the corner:

A12: Section corner 31 T.1 S.R.10 E., found iron pipe in concrete monument with mon. box. The selected location is accepted by the Contractor and is generally accepted by professional surveyor as the best available evidence of the position of the original corner. Placed Wayne Co. brass disk with license #10705.
 Found WCRC Tag & PK South face signal pole N. 60° E. dist. 58.84
 Set WCR Tag & nail S.W. face signal pole S. 40° E. dist. 81.65
 Found mon. box with concrete mon. iron pipe due South dist. 67.92 assumed to be E. 1/4 cor. Section 36, T.1 S.R.9 E. Livonia
 Found WCRC Tag & PK North face signal pole S. 38° W. dist. 101.88
 Set punch in center of NE bolt of steel signal light pole N. 70° W. dist. 48.21

Signed by William L. Roskelly

Date November 9, 1993

Surveyor's Michigan License No. 10705

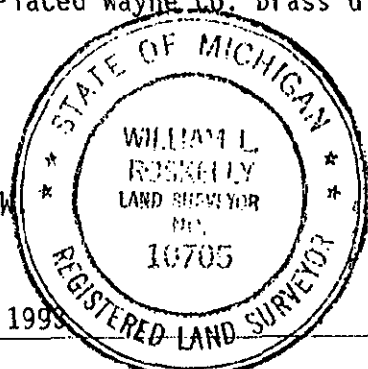

2R HKD

RECORDED - 7 PM 2/10