

MAY - 1 1995

COPY

RECORDED  
WASHTENAW COUNTY, MI

JAN 10 9 47 AM '95

COMMISSION LAND CORNER RECORDATION CERTIFICATE  
Filing Requirement of Act 74, Mich. P.A. 1970

For corners in  
Washtenaw

(County)

Located In:

Corner Code #

- 1. Public Land Survey T 1S R 3E M-13  
T \_\_\_\_\_ R \_\_\_\_\_  
T \_\_\_\_\_ R \_\_\_\_\_  
T \_\_\_\_\_ R \_\_\_\_\_
- 2. Property Controlling S \_\_\_\_\_ T \_\_\_\_\_ R \_\_\_\_\_  
in Section S \_\_\_\_\_ T \_\_\_\_\_ R \_\_\_\_\_
- 3. Miscellaneous S \_\_\_\_\_ T \_\_\_\_\_ R \_\_\_\_\_  
Property in Sec. S \_\_\_\_\_ T \_\_\_\_\_ R \_\_\_\_\_

PEGGY M. HAINES  
COUNTY CLERK/REGISTER

- Copy -

LIBER

1 PAGE 300 RM

- Copy -

Register of Deeds Stamp & File Number

- 4. Lot No. \_\_\_\_\_, Recorded Plat \_\_\_\_\_
- 5. Private Claims \_\_\_\_\_

	A	B	C	D	E	F	G	H	I	J	K	L
2	6	5	4	3	2	1						
3												
4	7	8	9	10	11	12						
5												
6	18	17	16	15	14	13						
7												
8	19	20	21	22	23	24						
9												
10	30	29	28	27	26	25						
11												
12	31	32	33	34	35	36						
13												

I, Charles C. Wilson, in a field survey on November 22, 1994, do hereby certify that under requirements of P.A. 74, Michigan P.A. of 1970, the corner points mentioned in lines 1 and 2 above were in conformance with regulations and rules therefore as required in the current manual of survey instructions of the United States Department of the Interior, Bureau of Land Management or by a decree of a Court of Law and/or that the corner points mentioned in lines 3, 4 and 5 above were in conformance with the rules of the Michigan Board of Land Surveyors or by a Decree of a Court of Law; established, re-established, monumented, re-monumented, recovered, found as expressed below:

NOTE: Not more than 4 corners, all in the same town and range, may be recorded on this certificate.

A. Description of original monument and accessories and/or subsequent restoration:

United States Government Survey, 1815 Instructions. Surveyed 1815, Bearing Trees B. Oak 16" S82deg.W 109 Links(71.94)  
B. Oak 9" N24deg.W 243 Links(160.38)  
Meas. (N) 40 Chains(2640)  
(W) 40 Chains(2640)

Russell Whipple, 1840's  
W. Oak 24" S60deg.W 164 Links(108.24)

Continued on back:


B. Description of corner evidence found and/or method applied in restoring or reestablishing corner:

Found a 2"(OD)-1-1/2"(ID) Iron Pipe surrounded by Stones & Bricks, 5" below ground surface. I believe this to be the point set by W.J. Armstrong in 1935. Raised to ground surface with a 1-1/2"(OD)x18" Iron Pipe with a Remonumentation Cap stamped #13604.

C. Description of monument for corner and accessories established to perpetuate locating the position of the corner:

Corner (M-13) 1-1/4"(OD)-1"(ID) Iron Pipe, with a Remonumentation Cap stamped #13604, over a 2"(OD)-1-1/2"(ID) Iron Pipe  
48" Stump N15deg.E 23\* 30" Oak N77deg.E 77.53(Nail & RT S/S)\*  
18" Oak S50deg.W 29.44(Nail & RT SE/S)\* 8" Oak (Dead) S53deg.W 29.3\*  
24" Oak S77deg.W 67.18(Nail & RT S/S)\* Chiseled "X" in Rock N39deg.W 0.83\*  
20" Stump S53deg.W 40.3\* 10" Hickory N45deg.W 5.20(Nail & RT SW/S)\*  
20" Oak N40deg.W 12.67(Nail & RT E/S)\*

\*indicates accessory previously mentioned in Paragraph A  
I find no evidence to conflict with the acceptance of this point as being a careful and faithful perpetuation of the position of the original point.

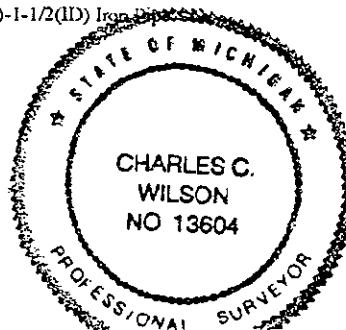

December 2, 1994

Signed by Charles C. Wilson

13604

Date \_\_\_\_\_

Surveyor's Michigan License No. \_\_\_\_\_

LIBER

1 PAGE 301 RM

- Copy -

Paragraph A Continued:

William J. Armstrong, PS #2444, May 23, 1932  
Found 1" Iron Pipe under a Pointed Stone. Set 1"x24" Iron Pipe on top with 4 Bricks.  
W. Oak 36" N27deg.E 55.8  
W. Oak 12" S34deg.W 62.7  
W. Oak 6" S19deg.E 78.65  
Walnut 10" S89deg.W 36.6  
R/W Iron Pipe E'ly 33'  
R/W Iron Pipe W'ly 33'

William J. Armstrong, PS #2444, May 17, 1938  
Book 134, Page 56

Washtenaw County Road Commission, 1946  
36" Oak N27deg.E 55.8  
12" Oak S34deg.W 62.7  
6" Oak S19deg.E 78.6  
10" Walnut S89deg.W 36.6

C. Wilson & Associates, Inc., September 30, 1977  
Charles C. Wilson, PS #13604  
Found Boat Spike in Pavement Liber 4, Page 330  
60" W. Oak N27deg.E 55.8  
24" W. Oak S34deg.W 62.35(nail)  
24" Walnut S89deg.W 36.63(nail)

C. Wilson & Associates, Inc., September 30, 1977  
Charles C. Wilson, PS #13604  
Found Boat Spike  
Same as Liber 4, Page 330  
Iron Bar (A-9) T1S, R4E, N'ly 90.23

Land Surveying Consultants  
Found Boat Spike  
52" Oak N25deg.E 54.07(nail W/S)  
40" Oak S30deg.W 62.33(nail E/S)  
35" Oak S88deg.W 36.88(nail S/S)  
1/2" Iron Bar (A-9) T1S, R4E, N'ly 90.30  
14" Maple S60deg.E 73.28(nail S/S)

Washtenaw Engineering Co., Inc., August 20, 1991  
Norman N. Fahrner, PS #17620  
Found Square Bolt  
48" W. Oak N27deg.E 54.07(nail)  
10" Walnut S89deg.W 36.80(nail)  
(A-9) T1S, R4E, N'ly 90.27  
6" Walnut N40deg.W 46.93(nail)

Washtenaw Engineering Co., Inc., June 17, 1993  
Norman N. Fahrner, PS #17620  
Found Square Bolt  
Same as August 20, 1991

APPROVED

DATE

11/28/94

CO. REP

KA