

MAR 04 1998

LAND CORNER RECORDATION CERTIFICATE

SECTION FILING REQUIREMENT OF ACT 74, MICH. P.A. 1970

1997 Alcona County Remonumentation

FOR CORNERS OF--:	LOCATED IN--:	CORNER CODE NUMBER
1. PUBLIC LAND SURVEY_____	T. 25N N. S., R. 5E E. W.	W 1/4 cor. 29 C-10
2. PROPERTY CONTROLL- ING IN SECTION_____	, T. _____ N. S., R. _____ E. W.	_____
3. MISCELLANEOUS PROPERTY IN SECTION_____	, T. _____ N. S., R. _____ E. W.	_____
4. LOT NO. _____, RECORDED PLAT _____		
5. PRIVATE CLAIMS _____		

APPROVED LAND CORNER
P A 345 of 1990
ALCONA COUNTY

Date 7/24/97
County Rep. D. B. L.

RECORDED

Date September 8, 1997
REMON LIBER 1 PAGE 254

2:20 Time P M
Doris A. Gauthier
Doris A. Gauthier
REGISTER OF DEEDS

REGISTER OF DEEDS STAMP AND
FILING NUMBER

I, John F. Oliver do hereby certify that under requirements of P.A. 74, Michigan P.A. of 1970, the corner points mentioned in lines 1 and 2 above (identified with circles on index code diagram—over) were, in a field survey on Aug. 20, 1997, established, re-established, monumented, re-monumented, recovered or restored as expressed below and in conformance with regulations and rules therefore as required in the current manual of survey instructions of the United States Department of the Interior, Bureau of Land Management or by a decree of a court of law. Furthermore, that the corner points mentioned in lines 3, 4 and 5 above were, in a field survey on 19, found, recovered, restored, established or re-established as expressed below and in conformance with the rules of the Michigan State Board of Registration for Land Surveyors or, by a Decree of a Court of law:

A. Description of original monument and accessories and/or subsequent restoration:

1845: G.L.O. - set post and referenced

1906: E. Chapelle - set post

1933: Dependent resurvey - placed 6" x 24" conc. mon. w brass tablet

B. Description of corner evidence found and/or method applied in restoring or re-establishing corner:


fd. 1/2" rod and cap (not readable)

accepted as true position for the corner

C. Description of monument for corner and accessories established to perpetuate locating the position of the corner:

Placed pavement box with brass cap stamped to identify the corner on a 1/2" bar.

referenced: power pole / S 25°E / 66.73'
14" cedar / S 30°W / 80.00'
13" ash / N 40°E / 73.73'
power pole / N 65°W / 69.56'
roads N, S and E

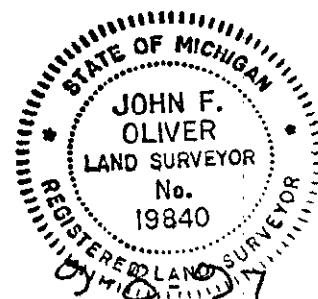

SIGNED BY _____ DATE _____

SURVEYOR'S MICHIGAN REGISTRATION NO. 19840 (SEAL)

FOR STATE AND UNITED STATES AGENCIES:

SIGNED BY _____ DATE _____
CHIEF OF SURVEY PARTY

APPROVED AND SIGNED BY _____ DATE _____
MICHIGAN REGISTERED LAND SURVEYOR (SEAL)

SURVEYOR'S MICHIGAN REGISTRATION NO. _____