

# SURVEY & REMONUMENTATION

FEB 07 2001

2000 ALCONA COUNTY REMONUMENTATION CORNER

## LAND CORNER RECORDATION CERTIFICATE Filing Requirement of Act 74, Mich. P.A. 1970

### SECTION

For corners in

Alcona  
(County)

Located In:

Corner Code #

1. Public Land Survey

T26N R7E

D-3

Millen Twp.

2. Property Controlling  
in Section

S

T

R

3. Miscellaneous  
Property in Sec.

S

T

R

Alcona County  
Remonumentation

Liber 2 Page 74

Filed for Record in  
ALCONA COUNTY MICHIGAN  
DORIS A GAUTHIER  
On 09-20-2000 At 09:42 am.  
LAND CORNER 9.00

Register of Deeds Stamp & File Number

4. Lot No. , Recorded Plat

5. Private Claims

I, Thomas L. Fabis, in a field survey on Sept. 8, 2000 do hereby state that under requirements of P.A. 74, Michigan P.A. of 1970, the corner points mentioned in lines 1 and 2 above were in conformance with regulations and rules therefore as required in the current manual of survey instructions of the United States Department of the Interior, Bureau of Land Management or by a decree of a Court of Law and /or that the corner points mentioned in lines 3, 4 and 5 above were in conformance with the rules of the Michigan Board of Land Surveyors or by a Decree of a Court of Law; established, re-established, monumented, recovered, found as expressed below:

NOTE: Not more than 2 corners, all in the same town and range, may be recorded on this certificate.

	A	B	C	D	E	F	G	H	I	J	K	L	M
1													
2		6		5		4		3		2		1	
3													
4		7		8		9		10		11		12	
5													
6		18		17		16		15		14		13	
7													
8		19		20		21		22		23		24	
9													
10		30		29		28		27		26		25	
11													
12		31		32		33		34		35		36	
13													

#### A. Description of original monument and accessories and/or subsequent restoration:

- 1838: G.L.O. Survey Lewis Clason set post & referenced: Beech 12 S7W 29, Maple 10 N54E 15
- 1907: Edward Chapelle County Survey orig. not found, set 1/4 post & referenced.
- 1984: NELS Survey John Oliver found 1/2" bar.
- 1989: U.S.D.A. Forest Service Survey L.232 P.907-909 & L.C.R.C. L.1 P.411 by John Korr found 1/2"x18" rebar & replaced with 5"x5"x36" Conc. Mon. w/brass cap & referenced.
- 1993: NELS Survey Liber 267 Page 36 John Oliver found 1/2" bar.

#### B. Description of corner evidence found and/or method applied in restoring or reestablishing corner:

- 2000: Found Conc. Mon. in centerline of E-W gravel road bent over, brass cap gone. We straightened corner. Found existing blazed trees with spikes tag #24600: 6" Elm S32E 37.73, 6" Maple S28W 59.09, 12" Oak N63W 69.34, 6" Dead Birch N10W 31.19. Also found carsonite post S6E 33'.

The position of this corner is compatible with Federal, county and local surveys and is accepted as a careful and faithful perpetuation of the position of the original corner.

#### C. Description of monument for corner and accessories established to perpetuate locating the position of the corner:

- 2000: Set 3" dia. alum. cap, stamped to identify the corner, over the existing Conc. Mon. Witnesses are"

Blazed 6" Elm S32E 37.73  
Blazed 6" Maple S28W 59.09  
Blazed 12" Oak N63W 69.34  
Set tag #31591 in 6" Twin Birch N32E 48.79  
Carsonite post S6E 33'

APPROVED LAND CORNER  
P A 345 of 1990  
ALCONA COUNTY


Date: 8-28-2000  
County Rep. Det. B. Gault

Signed by

Thomas L. Fabis

Date September 12, 2000

Surveyor's Michigan License No. 31591

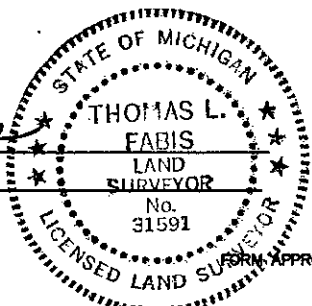

FORM APPROVED BY MICHIGAN STATE BOARD OF PROFESSIONAL SURVEYORS, JAN. 28, 1971  
REVISED MAY 14, 1975  
REVISED JAN., 1983  
REVISED OCT., 1985