SURVEY & REMONUMENTATION

___ , Recorded Plat _

5. Private Claims

APR 241995 1994 Alcona County Remonumentation Corner


Alcona County Remonumentation Liber / Page


RECORDED


COMMISSION LAND CORNER RECORDATION CERTIFICATE

		Filing Requi	irement of Act 74, Mich. P.A.	1970
For corners in			95 .	
	Alcona (County)	Located In:	Corner Code #	DEC 19 12 16 PH 184
1.	Public Land Survey	T R T R T R T R	ED LAND COR 345 of 1990 ONA COUNTY 2 2 9 4	Janie a Britaine REGISTEH OF DEEDS ALCONA COUNTY MICHIGAN
2.	Property Controlling	S 10 T 26N R 7E S T R	H-4>40	E.J.Z.
3.	in Section Miscellaneous Property in Sec.	S T R S T R	Date Cour	Register of Deeds Stamp & File Number

David B. Guthriein a field survey on _	December	<u>17</u> , 19 <u>94</u> ,				
do hereby certify that under requirements of P.A. 74, Michigan P.A. of 1970, the corner points mentioned in lines 1 and 2 above were in conformance with regulations and rules therefore as required in the current manual of survey instructions of the United States Department of the Interior, Bureau of Land						
above were in conformance with the rules of the Michiga	an Board of Land Survey	ors or by a Decree of a				
Court of Law, established, re-established, monumer	nted, re-monumented,	recovered, found as				

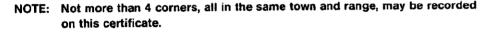

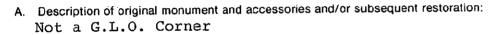

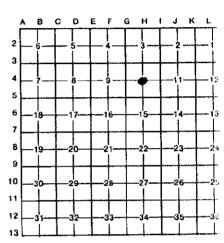

B. Description of corner evidence found and/or method applied in restoring or reestablishing corner: Set a 5/8" Iron Rod at the intersection of the North/South and East/West 1/4 Lines.

C. Description of monument for corner and accessories established to perpetuate locating the position of the corner: Set 5/8" Iron Rod with a 3" Aluminum Cap stamped to identify the Corner.

Referenced -N07°E - 6" Maple - 55.35 Feet

N40°E - 14" Maple - 23.72 Feet S17°E - 6" Maple - 19.55 Feet

N26°W - 12" Maple - 55.39 Feet

N40°E - Fence Corner - 4.25 Feet

Signed by .

22435