

SURVEY & REMONUMENTATION

FEB 07 2001

2000 ALCONA COUNTY REMONUMENTATION CORNER

SECTION

LAND CORNER RECORDATION CERTIFICATE

Filing Requirement of Act 74, Mich. P.A. 1970

For corners in Alcona
(County)

Located In:

Corner Code #

Alcona County
Remonumentation
Liber 2 Page 79

1. Public Land Survey

T 26N R 7E D-1, Millen Twp.
T 27N R 7E D-13, Hawes Twp.

0
Filed for Record in
ALCONA COUNTY MICHIGAN
DORIS A GAUTHIER
On 09-20-2000 At 09:42 am.
LAND CORNER 9.00

2. Property Controlling
in Section

S T R

3. Miscellaneous

S T R

Property in Section

S T R

Register of Deeds Stamp & File Number

4. Lot No. , Recorded Plat

5. Private Claims

T26N - R7E

	A	B	C	D	E	F	G	H	I	J	K	L	M
2	6		5		4		3		2				
3													
4	7		8		9		10		11		12		
5													
6	18		17		16		15		14		13		
7													
8	19		20		21		22		23		24		
9													
10	30		29		28		27		26		25		
11													
12	31		32		33		34		35		36		
13													

I, Thomas L. Fabis, in a field survey on Sept. 8, 2000, do hereby certify that under requirements of P.A. 74, Michigan P.A. of 1970, the corner points mentioned in lines 1 and 2 above were in conformance with regulations and rules therefore as required in the current manual of survey instructions of the United States Department of the Interior, Bureau of Land Management or by a decree of a Court of Law and/or that the corner points mentioned in lines 3, 4 and 5 above were in conformance with the rules of the Michigan Board of Professional Surveyors or by a Decree of a Court of Law; established, re-established, monumented, re-monumented, recovered, found as expressed below:

NOTE: Not more than 4 corners, all in the same town and range, may be recorded on this certificate.

A. Description of original monument and accessories and/or subsequent restoration:

1838: G.L.O. Survey Lewis Clason set post & referenced.
1956: Splaney Sub. L.1 P.169 James Scott measures to it.
1976: NELS Survey L.164 P.673 & 674 John Oliver measures to it.
1977: Verner Park Sub. L.3 P.38 Richard Miller measures to it.
1970's: R.S.Scott W.O.1-1114 David Guthrie ex. pipe, raised w/nail & referenced.
1979: L.C.R.C. L.1 P.76 John Oliver nail over I.P. and referenced.
1984: Survey L.195 P.216 Richard Miller measures to it.
1989: NELS Survey L.228 P.498 John Oliver measures to it.
1994: Survey L.281 P.633 & 634 Duane MacNeill Fnd. P.K. Measures to C-1.
1998: Survey & Section Notes John Oliver Found P.K. nail

B. Description of corner evidence found and/or method applied in restoring or reestablishing corner:

2000: Found P.K. nail in center of 1" Iron Pipe centerline of E-W (Bit. surface) Trask Lake Road. Found one witness: N5W P. Pole 69.48
The position of this corner harmonizes with all local surveys mentioned except the Richard Miller surveys. (Measurements to his surveys indicate that the corner he used is 8' West of this corner.)

The position of the 1" Iron Pipe is accepted as a careful and faithful perpetuation of the position of the original corner.

C. Description of monument for corner and accessories established to perpetuate locating the position of the corner:

2000: Removed P.K. nail. Set 1/2" iron rod inside existing iron pipe and capped with a 3" dia. brass cap, stamped to identify the corner. A Mon. Box was installed over the corner. Witnesses are:

P. Pole N5W 69.48
Fe. Post N37W 38.00
12" Twin Box Elder S45W 67.21
16" Box Elder S15W 79.92


APPROVED LAND CORNER
P A 345 of 1990
ALCONA COUNTY

Date 8-24-2000
County Rep DLH

Signed by

Thomas L. Fabis

Surveyor's Michigan License No. 31591

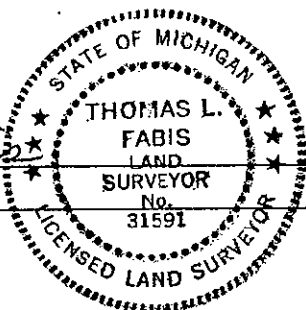

Date September 12, 2000

FORM APPROVED BY MICHIGAN STATE BOARD OF PROFESSIONAL SURVEYORS, JAN. 28, 1971
REVISED MAY 14, 1975
REVISED JAN, 1983