

Approved by Alger County
Land Survey Remonumentation
Peer Group Under Act 345 of
P.A. of 1990 On 12-12-1995

JAN 23 1996

COMMISSION

4-340

Donald W. Carlson
Chairman

LAND CORNER RECORDATION CERTIFICATE
Filing Requirement of Act 74, Mich. P.A. 1970

For corners in Alger Located In: _____ Corner Code # _____
(County)

- | | | | | | |
|------------------------------------|---|-----|---|-----|-----|
| 1. Public Land Survey | T | 45N | R | 21W | H13 |
| | T | 44N | R | 21W | H1 |
| | T | | R | | |
| | T | | R | | |
| 2. Property Controlling in Section | S | | T | | R |
| | S | | T | | R |
| 3. Miscellaneous | S | | T | | R |
| Property in Section | S | | T | | R |

REC'D and FILED

DEC 20 1995

2:45 p.m.

DONALD W. CARLSON, County Clerk
ALGER COUNTY, MI

Register of Deeds Stamp & File Number

4. Lot No. _____, Recorded Plat _____
5. Private Claims _____

I, Robert L. Jamros, in a field survey on June 13, 1995, 19_____, do hereby certify that under requirements of P.A. 74, Michigan P.A. of 1970, the corner points mentioned in lines 1 and 2 above were in conformance with regulations and rules therefore as required in the current manual of survey instructions of the United States Department of the Interior, Bureau of Land Management or by a decree of a Court of Law and/or that the corner points mentioned in lines 3, 4 and 5 above were in conformance with the rules of the Michigan Board of Professional Surveyors or by a Decree of a Court of Law; established, re-established, monumented, re-monumented, recovered, found as expressed below:

A	B	C	D	E	F	G	H	I	J	K	L
2	6		5		4		3		2		1
3											
4	7		6		9		10		11		12
5											
6	18		17		16		15		14		13
7											
8	19		20		21		22		23		24
9											
10	30		29		28		27		26		25
11											
12	31		32		33		34		35		36
13											

NOTE: Not more than 4 corners, all in the same town and range, may be recorded on this certificate.

A. Description of original monument and accessories and/or subsequent restoration:

H13: PLS-William A. Burt, DS, 1841, Set Qr. Section Post- Cedar 16", N.72 E., 25 links, Birch 16", N.33 W., 32 links. George Depew, County Surveyor, 1917, Set standard iron corner from government field notes. One government BT found. No references given. Record of surveys book, page 370. CCI Forestry Division, Land Corner Record No. 898, Robin D. Steinhof, 1967, Found brass cap iron at quarter section corner. Established the following references. Sugar 6", WEST, 8.2 feet, Maple 6", S.15 E., 10.9 feet.

B. Description of corner evidence found and/or method applied in restoring or reestablishing corner:


H13: Found 2 1/4" galvanized iron pipe with 3 1/4" brass cap stamped to identify corner position, dated september 12, 1917. Located corner position by measurement from north line of section 34. A search was made at the GLO bearing tree locations. In the NW position, GLO, Birch 16", N.33 W., 32 links, found downed section of birch BT. Blaze scar with rusted location tag growing within, direction and distance set well with corner position. BT in NE position, No evidence was found. Found four existing NBT's not of record and author unknown. Corner lies on east edge of north-south tote road. Corner position is accepted as a careful and faithful perpetuation of the position of the original corner.

C. Description of monument for corner and accessories established to perpetuate locating the position of the corner:

H13: Stamped P.A. 345 in brass cap of cast steel monument. Renewed existing reference trees w/ BT signs and paint. Set PK nails for measure w/ Alum. I.D. washers in the following reference trees. Ex. Maple 10", N.61 1/2 W., 25.95 feet, " 1/4s NBT ", Ex. Maple 4", S.75 E., 13.30 feet, " 1/4s NBT ", EX. Twin Maple 10" & 7", S.12 1/2 E., 11.00 feet, " Dbl. Blzd.", Ex. Maple 16", S.69 W., 41.76 feet, " 1/4s NBT ", Ex. Hemlock 10", N.46 E., 11.50 feet, " 1/4s NBT ", Survey Marker sign on six foot steel post, S.41 E., 1.1 feet. All bearings are magnetic.

Signed by Robert L. Jamros

Surveyor's Michigan License No. 25849

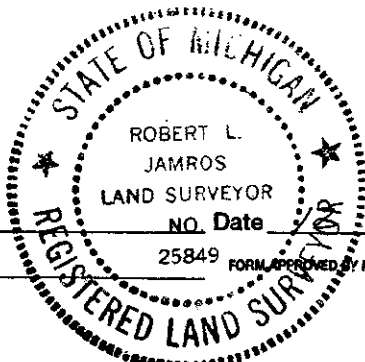

NO. Date 18 December 1995