

MAR 07 2000

ALLEGAN COUNTY REMONUMENTATION

SECTION

LAND CORNER RECORDATION CERTIFICATE

Filing Requirement of Act 74, Mich. P.A. 1970

For corners in

ALLEGAN COUNTY..... Located in: LEE..... Township
Corner Code #

1. Public Land Survey T.1 N. R.15 W. H-7.....
T..... R..... N1/4 POST SEC. 22
2. Property Controlling S..... T..... R.....
in Section S..... T..... R.....
3. Miscellaneous S..... T..... R.....
Property in Sec. S..... T..... R.....
4. Lot No., Recorded Plat
5. Private Claims.....

George J. Mitchell
REGISTERED PROFESSIONAL
SURVEYOR
ALLEGAN COUNTY

00 FEB -1 AM 8:42

FILED

LIBR0007 PAGE 335

Register of Deeds Stamp & File Number

I, **George J. Mitchell**....., in a field survey on **September 29, 1999**.....
do hereby certify that under requirements of P.A. 74, Michigan P.A. of 1970, the corner
points mentioned in lines 1 and 2 above were in conformance with regulations and rules
therefore as required in the current manual of survey instructions of the United States
Department of the Interior, Bureau of Land Management or by decree of a Court of Law
and/or that the corner points mentioned in lines 3, 4, and 5 above were in conformance
with the rules of the Michigan Board of Land Surveyors or by decree of a Court of Law;
established, re-established, monumented, re-monumented, recovered, found as expressed
below:

A. Description of original monument and accessories and/or subsequent restoration:

H-7

SEE SHEET 2 OF 2 FOR CORNER HISTORY

B. Description of corner evidence found and/or method applied in restoring or reestablishing corner:

FOUND 1" PIPE FROM ITEMS 2, 3, AND 4 OF CORNER HISTORY, AND IS ACCEPTED AS A CAREFUL AND
FAITHFUL PERPETUATION OF THE POSITION OF THE ORIGINAL CORNER.

SET ALLEGAN COUNTY STANDARD 3/4" BY 36" IRON PIN WITH REMON CAP.

THIS CORNER WAS APPROVED BY THE ALLEGAN COUNTY SURVEYORS PEER GROUP ON OCTOBER 12, 1999

C. Description of monument for corner and accessories established to perpetuate locating the position of the corner:

NORTH QUARTER POST, SECTION 22, TOWN 1 NORTH, RANGE 15 WEST

A.C. REMON TAG & NAIL IN NORTHEAST SIDE OF 50" OAK
A.C. REMON TAG & NAIL IN SOUTHWEST SIDE OF 10" OAK
A.C. REMON TAG & NAIL IN NORTH SIDE OF 30" OAK
CENTER OF TOP OF SOUTH GATE POST (6" PIPE/ CONCRETE)
CORNER IS IN LINE WITH SOUTH LINE OF TRAIL TO EAST
CENTER OF NORTH-SOUTH GRAVEL ROAD WEST 3'
H-7 TO H-6 MEASURED 2651.28 FEET
H-7 TO H-8 MEASURED 2613.26 FEET

AZ.	070°	44.75 FEET
AZ.	225°	65.50 FEET
AZ.	260°	36.42 FEET
AZ.	090°	35.67 FEET

APPROVED REMONUMENTATION CORNER
P.A. 345 OF 1990
ALLEGAN COUNTY
DATE APPROVED Oct. 12, 1999
COUNTY REP. John J. Smith

Signed by


George J. Mitchell

Date

10/28/99

Surveyor's Michigan License No.19618.....

SHEET 1 OF 2

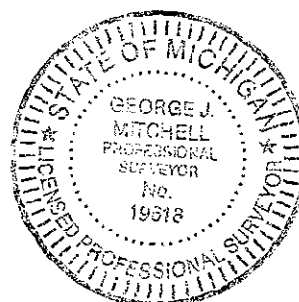

PROPERTY &
RECORDS

MAR 07 2000

SECTION

GOVERNMENT CORNER HISTORY

SOUTH QUARTER POST OF SECTION 15
TOWN 1 NORTH, RANGE 15 WEST

H-7

1. C. BRITAIN D.S. 1831 RANDOM LINE BETWEEN SECT 15 & 22. SET TEMP STAKE AT 40 CHAINS. INTERSECT E. LINE OF SECT AT 79.78 CHAINS 3 LKS N. OF POST. WEST CORRECT BETWEEN SECT 15 & 22 - 39.89 CHAINS TO 24 PINE.
2. OLD NOTES NO DATE IRON
MACDOUGHAL 2615 SOUTH TO CENTER
14" MAPLE WEST 18.3'
30" MAPLE NE 10.5'
12" MAPLE EAST 14.5'
3. D. RATEKIN P.S. 1970 FD 1" PIPE
MEASURED 2613.66' TO CENTER
4. D. RATEKIN P.S. 1973 L.C.R.C. L. 002, P. 202
FD. 1" PIPE
14" BLACK OAK S80W 35.9'
16" RED OAK WEST 47.8'
30" OAK N50E 43.8'
5. G. MITCHELL P.S. 1999 FD 1" PIPE
MEASURED 2613.26' SOUTH TO CENTER

LIBR0007 PAGE 36