

SURVEY &
EMONUMENTATION

APR 29 1996

COMMISSION

ALLEGAN COUNTY REMONUMENTATION
LAND CORNER RECORDATION CERTIFICATE
Filing Requirement of Act 74, Mich. P.A. 1970

For corners in

Form with fields for County (ALLEGAN), Located in, Corner Code #, and numbered sections 1-5 for Public Land Survey, Property Controlling, Miscellaneous, Lot No., and Private Claims.

1995 DEC 14 PM 2:40
Register of Deeds Stamp & File Number

FILED

1. BASIL ADDRESS in a field survey on 15 MAR 19 95
do hereby certify that under requirements of P.A. 74, Michigan P.A. of 1970, the corner points mentioned
in lines 1 and 2 above were in conformance with regulations and rules therofore as required in the
current manual of survey instructions of the United States Department of the Interior, Bureau of Land
Management or by a decree of a Court of Law and/or that the corner points mentioned in lines 3, 4 and 5
above were in conformance with the rules of the Michigan Board of Land Surveyors or by a Decree of a
Court of Law, established, re-established, monumented, re-monumented, recovered, found as
expressed below

NOTE: Not more than 4 corners, all in the same town and range, may be recorded
on this certificate.

- A. Description of original monument and accessories and/or subsequent restoration.
G.L.O.
WEST ON SOUTH SIDE SECTION - 33
80.00 BEECH 9 CORNER SECTIONS - 32 & 33
1978 GERALD J. GRAY, P.E. & L.S.
SURVEY FOR PENN CENTRAL - SET 1/2" IRON W/ CAP
5.4' N 40 W R.R. TIE COR. POST
31.25' N 25 E 22" ASH
22.73' S 80 E 12" LOCUST
45.54' N 89°-52'-26" W NE COR SEC - 5
- B. Description of corner evidence found and/or method applied in restoring or reestablishing corner:
FD 1/2" IRON W/ CAP
ALL WITNESSES FROM 1978 SURVEY CHECK

APPROVED REMONUMENTATION CORNER
P.A. 345 OF 1990
ALLEGAN COUNTY
DATE APPROVED 3-14-95
COUNTY REP. [Signature]



THIS POSITION IS ACCEPTED AS A CAREFUL AND FAITHFUL
REESTABLISHMENT OF THE ORIGINAL CORNER.

SEE SKETCH ON BACK OF CERTIFICATE

- C. Description of monument for corner and accessories established to perpetuate locating the position of the corner:
REPLACED 1/2" IRON W. CAP W/ STD. ALLEGAN CO. MON. (3/4" X 36" PIN & CAP)
16d & REMON TAG W SDE TRIPLE ASH (10"-12"-14") N 10 W 54.05'
16d & REMON TAG N SDE 18" HONEY LOCUST S 80 E 22.72'
16d & REMON TAG NW SDE 24" WILLOW N 50 E 31.70'
16d & REMON TAG SE SDE MOST ELY SUPPORT POST (TRESTLE) S 30 W 29.45'
IN LINE W/ FE TO EAST
STD. ALLEGAN CO. MON (NE COR SEC-5, T-1N, R-12W) WEST 45.54'
C/L 112TH AVE (GRAVEL) NORTH 273'+


Signed by [Signature] Date 18 APR 95
Surveyor's Michigan License No. 30075

WATSON

TWP

SEC-32

SEC-33

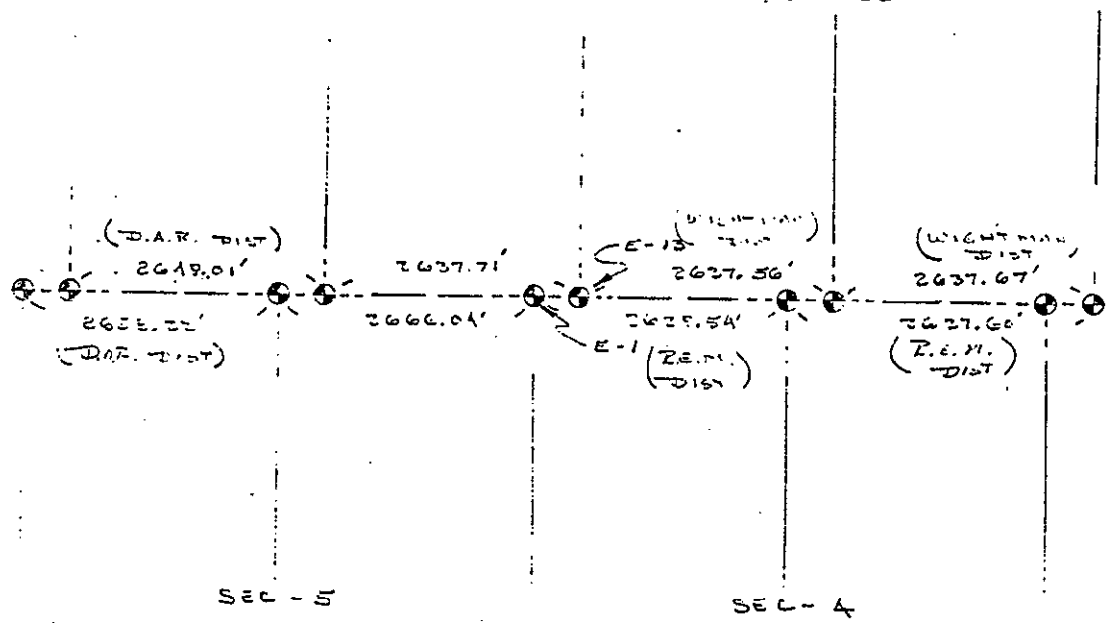

OTSEGO

TWP

