

RF

FILED

MAR 6 7 2000

Alleghan County Remonumentation

LAND CORNER RECORDATION CERTIFICATE FEB -1 AM 8:41
Filing Requirement of Act 74, Mich. P.A. 1970

SECTION

For corners in

Alleghan (County)	Located In:	Corner Code #
	Hopkins Twp.	
1. Public Land Survey	T3N R12W	H-5
	T R	
	T R	
	T R	
	T R	
2. Property Controlling in Section	S T R	
	S T R	
3. Miscellaneous Property in Sec.	S T R	
	S T R	

Jayce A. ...
REGISTER OF DEEDS
ALLEGAN COUNTY, MICH.

UNRECORDED

Register of Deeds Stamp & File Number

4. Lot No. _____, Recorded Plat _____
5. Private Claims _____

I, Robert J Jonker, in a field survey on 9-14, 1999 do hereby state that under requirements of P.A. 74, Michigan P.A. of 1970, the corner points mentioned in lines 1 and 2 above were in conformance with regulations and rules therefore as required in the current manual of survey instructions of the United States Department of the Interior, Bureau of Land Management or by a decree of a Court of Law and/or that the corner points mentioned in lines 3, 4 and 5 above were in conformance with the rules of the Michigan Board of Land Surveyors or by a Decree of a Court of Law; established, re-established, monumented, recovered, found as expressed below:

NOTE: Not more than 2 corners, all in the same town and range, may be recorded on this certificate.

	A	B	C	D	E	F	G	H	I	J	K	L	M
1													
2	6			5			4		3		2		1
3													
4	7			8			9		10		11		12
5													
6	18			17			16		15		14		13
7													
8	19			20			21		22		23		24
9													
10	30			29			28		27		26		25
11													
12	31			32			33		34		35		36
13													

A. Description of original monument and accessories and/or subsequent restoration:

Page 244, 245 GLO
West corrected between Section 10 and 15
39.95 set qr. Section post
B. ash, 12, S30°W, 19
B. ash 8, N41°E, 3

(over)

APPROVED REMONUMENTATION CORNER
P.A. 345 OF 1990
ALLEGAN COUNTY
DATE APPROVED SEPT 14 1999
COUNTY REP. *[Signature]*

B. Description of corner evidence found and/or method applied in restoring or reestablishing corner:

Found 1" pipe
Found old blaze in face 60" oak SW 50'+-


And as accepted as a careful and faithful perpetuation of the position of the original corner.

Peer group approved 9-14-99

Set 3/4" X 24" std. Alleghan Co. capped mon. in the top of the existing 1" pipe.

C. Description of monument for corner and accessories established to perpetuate locating the position of the corner:

found pk nail on W. side p. pole S18° E 36.47'
Found pk nail on E. side p. pole N28° E 27.20'
found pk nail on NE side p. pole N61° W 67.69'
set 60 D spk. on SE side 60' oak S47° W 52.57'
C/L E-W gravel road is 1' South
C/L of gravel road to South is 3' West

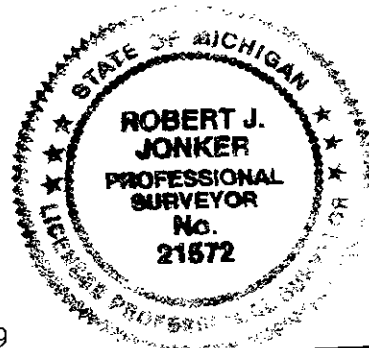

Signed by

Robert J. Jonker
21572

Surveyor's Michigan License No.

Date

9-14-99

1. Jonker Land Surveys, 1988, Job #88159
Found 1" pipe - no witnesses taken
2. Kurt Van Order, 1997, Job #97-3801
Found 1" pipe - No witnesses taken

RF

MAR 07 2000

SECTION

LIBR0007 PAGE310