

RE

MAR 07 2000

FILED

Allegan County Remonumentation
 LAND CORNER RECORDATION CERTIFICATE
 Filing Requirement of Act 74, Mich. P.A. 1970

FEB -1 AM 8:41

SECTION

For corners in

Allegan

(County)

Located in:

Hopkins Twp.

Corner Code #

1. Public Land Survey

T3N R 12W

M-3

T R

T R

T R

T R

2. Property Controlling
in Section

S

T R

S

T R

3. Miscellaneous
Property in Sec.

S

T R

S

T R

4. Lot No. , Recorded Plat

5. Private Claims

I, Robert J Jonker, in a field survey on 12-10, 1999 do hereby state that under requirements of P.A. 74, Michigan P.A. of 1970, the corner points mentioned in lines 1 and 2 above were in conformance with regulations and rules therefore as required in the current manual of survey instructions of the United States Department of the Interior, Bureau of Land Management or by a decree of a Court of Law and/or that the corner points mentioned in lines 3, 4 and 5 above were in conformance with the rules of the Michigan Board of Land Surveyors or by a Decree of a Court of Law; established, re-established, monumented, recovered, found as expressed below:

NOTE: Not more than 2 corners, all in the same town and range, may be recorded on this certificate.

A. Description of original monument and accessories and/or subsequent restoration:

GLO - set post
 Beech 6 N47°W 19'
 Sycamore 9 S79°W 10'

APPROVED REMONUMENTATION CORNER
 P.A. 345 OF 1990
 ALLEGAN COUNTY
 DATE APPROVED DEC 14, 1999
 COUNTY REP. Robert J. Jonker


B. Description of corner evidence found and/or method applied in restoring or reestablishing corner:
 Found 3/4" pipe by witnesses listed in part "A" for LCRC 3-413
 Replaced with 3/4" X 36" std. capped Allegan Co. Mon.

Peer group approved 12-14-99

And is accepted as a careful and faithful perpetuation of the position of the original corner.

C. Description of monument for corner and accessories established to perpetuate locating the position of the corner:

3/4" x 36" std. Allegan Co. capped monument
 Found nail & tag on West side p. pole S20°E 11.34'
 Face of steel fence corner post S55°E 25.24'
 Face of steel fence post S33°W 13.84'
 Set remon tag on SW side light pole N30°W 176.99'
 C/L of N-S road East 59'+-

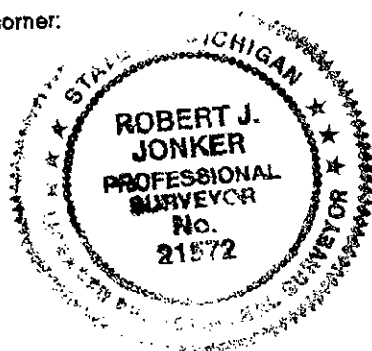

Signed by

Robert J. Jonker

Date

12-8-99

Surveyor's Michigan License No.

21572

Sheet 1 of 2

LIBERO 007 PAGE 314

M-3

Jonker - 1999

LCRC # 1-374, Don Ratekin - 1972
Part B - Found "T" iron
Part C - "T" iron
Fence line South 12.5'
8" poplar N45°W 5.8'
R.R. tie cor. post S65°E 27.2'
C/L Road East 59'

Check OK
Out
Out
Check OK

LCRC # 3-413, Jonker, 1985
Part A - Witnesses from part "C" in (1) above
Part B - Fd. $\frac{1}{2}$ " rerod in gravel (equip. parking lot)
Part C - $\frac{1}{2}$ " rerod
nail SW side p. pole S20°E 11.35'
E-W fence, South 12.1'
N-S fence, East 22.7'
Face Steel fe. cor. post S55°E 25.25'
Face steel fe. cor. post S50°W 21.8'
"T" iron south 107.29'

Check OK
Out
Check OK
Check OK
Check OK
" "

RECEIVED &
RECORDED

MAR 07 2000

SECTION

LIBERO 007 PAGE 315