

RE

MAR 07 2000

FILED

SECTION

Allegan County Remonumentation
LAND CORNER RECORDATION CERTIFICATE
Filing Requirement of Act 74, Mich. P.A. 1970

00 FEB -1 AM 8:39

1000007 PM232

For corners in

Allegan (County)	Located In:	Corner Code #
1. Public Land Survey	T 4N R 12W	E-10 (East 1/4 29) Dorr Twp.
	T R	
	T R	
	T R	
2. Property Controlling in Section	S T R	
	S T R	
3. Miscellaneous Property in Sec.	S T R	
	S T R	

Joyce M. Smith
REGISTER OF DEEDS
ALLEGAN COUNTY MI.

Register of Deeds Stamp & File Number

4. Lot No. _____, Recorded Plat _____
5. Private Claims _____

I, Steven Koerber, in a field survey on June 4, 1999 do hereby state that under requirements of P.A. 74, Michigan P.A. of 1970, the corner points mentioned in lines 1 and 2 above were in conformance with regulations and rules therefore as required in the current manual of survey instructions of the United States Department of the Interior, Bureau of Land Management or by a decree of a Court of Law and/or that the corner points mentioned in lines 3, 4 and 5 above were in conformance with the rules of the Michigan Board of Land Surveyors or by a Decree of a Court of Law; established, re-established, monumented, recovered, found as expressed below:

NOTE: Not more than 2 corners, all in the same town and range, may be recorded on this certificate.

	A	B	C	D	E	F	G	H	I	J	K	L	M
1													
2		6		5		4		3		2		1	
3													
4		7		8		9		10		11		12	
5													
6		18		17		16		15		14		13	
7													
8		19		20		21		22		23		24	
9													
10		30		29		28		27		26		25	
11													
12		31		32		33		34		35		36	
13													

A. Description of original monument and accessories and/or subsequent restoration:

E-10 GLO - L.Lyon DS 1831 1. Section breakdown notes from old Co. Surv.
Pine 6 N61°E 14 Dist from E-10 to D-10 2649.18
Beech 8 S17°E 18

(Additional info. on back of sheet)

B. Description of corner evidence found and/or method applied in restoring or reestablishing corner:

E-10 Found "T" iron
Nail in side 12" Oak WSW 31.18'
Nail in side 18" Oak WNW 45.91'
Nail in side 24" Oak E 35.71'
Nail in side 12" Oak S 35.55'


APPROVED REMONUMENTATION CORNER
P.A. 347-1-1990
ALLEGAN COUNTY

DATE APPROVED JUNE 8, 1999
COUNTY REP. [Signature]

This corner is accepted as a careful and faithful perpetuation of the position of the original corner.
Peer Group approval June 8, 1999.
Dist to D-10 = 2648.75'

C. Description of monument for corner and accessories established to perpetuate locating the position of the corner:

E-10 Set Standard Allegan Co. Mon. (3/4" x 24" Iron Rod with Remon.cap)
Set nail & Allegan Co. Remon. tag in W. side 20" Oak N15E 15.67'
Set nail & Allegan Co. Remon. tag in N. side 30" Oak S85E 35.50'
Set nail & Allegan Co. Remon. tag in N. side 24" Oak S75W 31.64'
Set nail & Allegan Co. Remon. tag in S. side 24" Oak N65W 45.80'

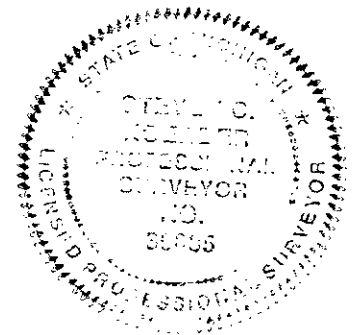

Signed by [Signature]
Surveyor's Michigan License No. 39085

Date 8-10-1999

MAR 07 2000

E-10 DORR TWP.

SECTION

2. Old note card witnesses- no date
"T" iron
Nail in side 40" Maple N 38.30'
Nail in side 24" Oak E 34.63'
Nail in side 10" Oak S 34.92'
Nail in side 10" Oak W-SW 30.69'
Recorded by Douglas Bonnema July 1973
3. 4-6-1973
L.C.R.C. L.2, Pg 101 Douglas Bonnema
Same wits as no. 2 above
4. 3-30-1973
Act 132 survey Exxel Eng.
Same wits as No. 2 above
5. 7-12-1974
L.C.R.C. L.2, Pg.315 John Clapp
Fnd "T" Iron @ fences
Same wits as No. 2 above
6. Holland Engineering wits
Same as No. 2 above
7. 7-15-1982
Jonker Land Surveys
Nail in side 12" Oak WSW 31.18'
Nail in side 18" Oak WNW 45.91'
Nail in side 24" Oak E 35.71'
Nail in side 12" Oak S 35.55'

LIBR0007 PAGE233