

SURVEY REMONUMENTATION

APR 29 1999

SECTION

Allegan County Remonumentation LAND CORNER RECORDATION CERTIFICATE Filing Requirement of Act 74, Mich. P.A. 1970

For corners in

Allegan
(County)

Located In:

Corner Code #

1. Public Land Survey

T4N R14W M-5 (SE, 12)
T R Overisel Twp.
T4N R13W A-5 (NW 18)
T R Salem Twp.

2. Property Controlling
in Section

S T R
S T R
S T R
S T R

3. Miscellaneous
Property in Sec.

FILED

1/28/1999 2:44:39 PM

JOYCE A. WATTS
REGISTER OF DEEDS
ALLEGAN COUNTY, MICH

Register of Deeds Stamp & File Number

4. Lot No. _____, Recorded Plat _____
5. Private Claims _____

I, John C. Bueche, in a field survey on May 8, 1998 do hereby state that under requirements of P.A. 74, Michigan P.A. of 1970, the corner points mentioned in lines 1 and 2 above were in conformance with regulations and rules therefore as required in the current manual of survey instructions of the United States Department of the Interior, Bureau of Land Management or by a decree of a Court of Law and/or that the corner points mentioned in lines 3, 4 and 5 above were in conformance with the rules of the Michigan Board of Land Surveyors or by a Decree of a Court of Law; established, re-established, monumented, recovered, found as expressed below:

NOTE: Not more than 2 corners, all in the same town and range, may be recorded on this certificate.

	A	B	C	D	E	F	G	H	I	J	K	L	M
1													
2		6		5		4		3		2		1	
3													
4		7		8		9		10		11		12	
5													
6		18		17		16		15		14		13	
7													
8		19		20		21		22		23		24	
9													
10		30		29		28		27		26		25	
11													
12		31		32		33		34		35		36	
13													

A. Description of original monument and accessories and/or subsequent restoration:

M-5 GLO, 1831 HEI inform., no dates Stone
Lucius Lyon, DS 3/4" steel bar 24" Walnut NW 37.50'
Set post Secs. 12 & 13 PP N 30° E 49.70' 36" Elm NW 63.50'
Beech 10 N 11 W 27 Sq. fence post S 60° E 53.66'
Sugar 16 S 16 W 17 36" Maple N 40° W 31.46' North 5274.6'
PP S 50° W 178.04'
Common Corner A-5 (NW 18, 4-13) OVER

B. Description of corner evidence found and/or method applied in restoring or reestablishing corner:

M-5 Found 3/4" solid rod in Mon. Box in bit.
C/L bit. E-W is South 1'±
PP N 30° E 49.70'±
PP S 50° W 178.04'±
Sq. fence post S 60° E 53.66'


APPROVED REMONUMENTATION CORNER
P.A. 345 OF 1990
ALLEGAN COUNTY
DATE APPROVED JUNE 9, 1998
COUNTY REP. John C. Bueche

Peer group approved 6-9-98.

And is accepted as a careful and faithful perpetuation of the position of the original corner.

C. Description of monument for corner and accessories established to perpetuate locating the position of the corner:

M-5 Placed Allegan Co. Cap on rod in Mon. Box
Nail & Allegan Co. Remon. Tag in SE side PP N 35° E 49.73'
Nail & Allegan Co. Remon. Tag in NW side PP S 50° W 177.94'
Nail & Allegan Co. Remon. Tag in N side PP N 50° W 60.41'
Nail & Allegan Co. Remon. Tag in top of 1'x1' fence post S 50° E 55.10'
C/L bit. E-W is South 1'±; C/L gravel N-S is East 5'±

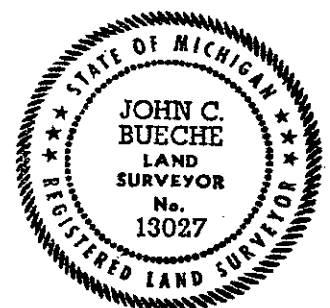

Signed by John C. Bueche
Surveyor's Michigan License No. 13027

Date 6-4-98

SURVEY
REMONUMENTATION

APR 29 1933

A-5 SALEM TWP.

M-5 OVERISEL TWP.

PART A - continued

SECTION

A-5 (NW 18)
HEI inform. sheet
Bent iron over stone 1967
Gas line marker NW 29.0'
28" Ash NW 29.7'
TP WSW 55.8'
Stop sign SW 30.8'
TP SE 64.0'

A-5 (NW 18)
LCRC 1-387, July, 1972, Ratekin
Fnd. 1" iron
Gas line marker N 50° W 29.0'
30" Ash N 40° W 29.6'
St. sign S 45° E 47.15'
L/C S. end 12" conc.

