

6-1-1004

Allegan County Remonumentation
LAND CORNER RECORDATION CERTIFICATE
Filing Requirement of Act 74, Mich. P.A. 1970

COMMISSION
For corners in

Allegan (County)	Located in:	Corner Code --#
1. Public Land Survey	T <u>4N</u> R <u>13W</u>	<u>E-13 (SE, 32)</u>
	T _____ R _____	<u>Salem Twp.</u>
	T _____ R _____	_____
	T _____ R _____	_____
2. Property Controlling in Section	S _____ T _____ R _____	_____
	S _____ T _____ R _____	_____
3. Miscellaneous Property in Sec.	S _____ T _____ R _____	_____
	S _____ T _____ R _____	_____
4. Lot No. _____, Recorded Plat _____		
5. Private Claims _____		

REGISTER OF DEEDS
ALLEGAN COUNTY, MICH.

003 DEC 17 PM 1:56

FILED

Register of Deeds Stamp & File Number

I, John C. Bucche, in a field survey on October 26, 19 93,
do hereby certify that under requirements of P.A. 74, Michigan P.A. of 1970, the corner points mentioned
in lines 1 and 2 above were in conformance with regulations and rules therefore as required in the
current manual of survey instructions of the United States Department of the Interior, Bureau of Land
Management or by a decree of a Court of Law and/or that the corner points mentioned in lines 3, 4 and 5
above were in conformance with the rules of the Michigan Board of Land Surveyors or by a Decree of a
Court of Law, established, re-established, monumented, re-monumented, recovered, found as
expressed below:

NOTE: Not more than 4 corners, all in the same town and range, may be recorded
on this certificate.

	A	B	C	D	E	F	G	H	I	J	K	L	M
2	6	5	4	3	2	1							
3													
4	7	6	5	4	3	2	1						
5													
6	10	9	8	7	6	5	4	3	2	1			
7													
8	13	12	11	10	9	8	7	6	5	4	3	2	1
9													
10	16	15	14	13	12	11	10	9	8	7	6	5	4
11													
12	19	18	17	16	15	14	13	12	11	10	9	8	7
13													

A. Description of original monument and accessories and/or subsequent restoration:

E-13 3/4" iron, no date	1990 Ratekin
24" Oak NW 78.8'	Found 3/4" pipe over stone,
22" Oak WNW 42.5'	replaced pipe
Steel fence cor. NE 48.37'	with new 3/4" pipe with cap, 1'± deep
2649.39' W to S 1/4 32	
2645.86' E to S 1/4 33	
67.32' W to NE 5, 3-13	

Found 3/4" pipe
LCRC L2, P93, 5-8-73
SW 96.34' PP
NW 38.75' PP
NE 88.78' PP

See back

B. Description of corner evidence found and/or method applied in restoring or reestablishing corner:

E-13 Found 3/4" pipe, down 1'±	Nail & washer E side
24" Oak NW 78.8'	PP SE 103.50'
Steel fence cor. NE 48.37'	PK E side PP SW 71.28'
Meas. W to SW 33, 2649.40'	Nail S side LP ENE 88.70'
Meas. W to NE 5, 3-13, 67.32' on line between S 1/4 & SE 32, 4-13	

PP SW 96.34'
PP NW 38.75'
PP NE 88.78'
Nail & Tag in NE
side PP NW 39.19'
PK SE side PP SW 71.32'
C/L top steel pipe
fence post NE 48.54'
C/L top steel pipe
fence post ENE 77.43'

And is accepted as a careful and faithful perpetuation of the
position of the original corner.

C. Description of monument for corner and accessories established to perpetuate locating the position of the corner:

E-13 Replaced 3/4" pipe with Std. Allegan Co. Mon. (3/4" x 24" Pin &
Cap), down 6"

Pin is on angle, hit stone

Conc. Nail & Allegan Co. Remon. Tag in E side PP S 50° W 96.33'
Conc. Nail & Allegan Co. Remon. Tag in NW side 8" Pine S 75° W 107.90'
Conc. Nail & Allegan Co. Remon. Tag in E side 30" Oak N 70° W 78.89'
Conc. Nail & Allegan Co. Remon. Tag in E side 12" Poplar N 40° W 76.29'
Conc. Nail & Allegan Co. Remon. Tag in S side PP N 50° E 44.90'

On C/L gravel road E-W

On C/L gravel road N

C/L gravel road S, W 56'±

Meas. by hand

Signed by


John C. Bucche

Date

Oct 26, 1993

Surveyor's Michigan License No.

13027

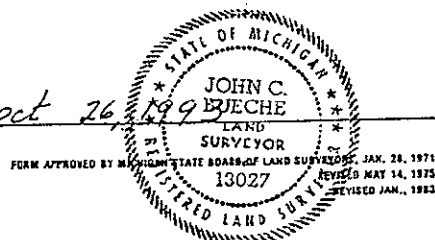

LIBER 004 PAGE 239

Page 1 of 2

3-9-92 3/4" pipe
over stone
Nail & washer E side
PP SE 103.50'
PK E side PP SW 71.28'
Nail S side LP ENE 88.70'

1" pipe 10-21-91
Survey VanOrder
Nail & Tag in NE
side PP NW 39.19'
PK SE side PP SW 71.32'
C/L top steel pipe
fence post NE 48.54'
C/L top steel pipe
fence post ENE 77.43'