

ALLEGAN COUNTY REMONUMENTATION  
LAND CORNER RECORDATION CERTIFICATE  
Filing Requirement of Act 74, Mich. P.A. 1970

For corners in

Allegan

(County)

Located In:

Corner Code #

1. Public Land Survey

T4N R15W

M-8

T R

T R

T R

East 1/4 corner,  
Section 24, Fillmore  
Twp.

2. Property Controlling  
in Section

S T R

S T R

3. Miscellaneous

S T R

Property in Sec.

S T R

4. Lot No. \_\_\_\_\_, Recorded Plat \_\_\_\_\_

5. Private Claims \_\_\_\_\_

I, Steve Lampen \_\_\_\_\_, in a field survey on December 19, 1998, do hereby certify that under requirements of P.A. 74, Michigan P.A. of 1970, the corner points mentioned in lines 1 and 2 above were in conformance with regulations and rules therefore as required in the current manual of survey instructions of the United States Department of the Interior, Bureau of Land Management or by a decree of a Court of Law and/or that the corner points mentioned in lines 3, 4 and 5 above were in conformance with the rules of the Michigan Board of Land Surveyors or by a Decree of a Court of Law; established, re-established, monumented, re-monumented, recovered, found as expressed below:

NOTE: Not more than 4 corners, all in the same town and range, may be recorded on this certificate.

A. Description of original monument and accessories and/or subsequent restoration:

M-8

No records

GLO - Lyon-Sibley - 1831

Set HMP

Sugar 6 S 35 W 22

Sugar 7 N 34 W 33

B. Description of corner evidence found and/or method applied in restoring or reestablishing corner:

M-8 Did not find any monumentation at corner. No written research was furnished. A-8, Town 4 North, Range 14 West, was shown on a Consumers Power Company survey in 1968 to be calculated mid-way and on line.

Set a 3/4"x24" Allegan County Remonumentation iron and cap mid-way and on line M-7 to M-9 and accepted it as A careful and faithful re-establishment of the position of the original corner.

M-8 was approved by the Allegan County Remonumentation Peer Group on December 22, 1998.

APPROVED REMONUMENTATION CORNER

P.A. 345 OF 1990

ALLEGAN COUNTY

DATE APPROVED DEC. 22, 1998

COUNTY REP. Steve Lampen

C. Description of monument for corner and accessories established to perpetuate locating the position of the corner:

M-8 3/4"x24" Allegan County Remonumentation iron and cap

Azimuth = Michigan State Plane grid direction

Power pole, remonumentation tag in W side 158° 05' 196.99


6" Ash, remonumentation tag in NW side 35° 04' 88.60

6" Ash, remonumentation tag in NW side 73° 54' 49.16

3" Ash, remonumentation tag in SW side 104° 56' 55.94

A-8, Town 4 North, Range 14 West 179° 36' 35.71

Centerline N and S gravel road 90° 6.

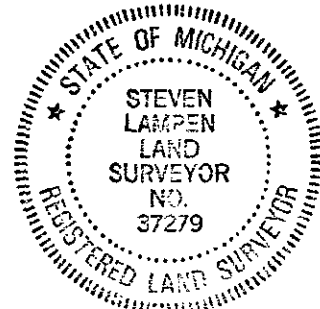

Signed by Steve Lampen

Date JANUARY 11, 1999

Surveyor's Michigan License No. 37279