

SURVEY & REMONUMENTATION

FEB 03 1998

1997 Alpena County Remonumentation Corner LAND CORNER RECORDATION CERTIFICATE Filing Requirement of Act 74, Mich. P.A. 1970

SECTION

For corners in:

Alpena

(County)

Located in:

Corner Code #

1. Public Land Survey

T29N R6E

K-7

2. Property Controlling
in Section

S

T

3. Miscellaneous
Property in Sec.

S

T

4. Lot No. _____, Recorded Plat _____
5. Private Claims _____

Liber 00002 Page 0119

STATE OF MICHIGAN
County of Alpena
Recorded
11-06-1997 15:31:42
Kathy J. Matash
REGISTER OF DEEDS

Register of Deeds Stamp & File Number

I, Daniel T. Kibbe, in a field survey on March 27, 1997 do hereby state that under requirements of P.A. 74, Michigan P.A. of 1970, the corner points mentioned in lines 1 and 2 above were in conformance with regulations and rules therefore as required in the current manual of survey instructions of the United States Department of the Interior, Bureau of Land Management or by a decree of a Court of Law and/or that the corner points mentioned in lines 3, 4 and 5 above were in conformance with the rules of the Michigan Board of Land Surveyors or by a Decree of a Court of Law; established, re-established, monumented, recovered, found as expressed below:

NOTE: Not more than 2 corners, all in the same town and range, may be recorded on this certificate.

P.A. 345 ALPENA COUNTY
PEER APPROVED 7/27/97
D. B. Carr

	A	B	C	D	E	F	G	H	I	J	K	L	M
1													
2		6		5		4		3		2		1	
3													
4		7		8		9		10		11		12	
5													
6		18		17		16		15		14		13	
7													
8		19		20		21		22		23		24	
9													
10		30		29		28		27		26		25	
11													
12		31		32		33		34		35		36	
13													


A. Description of original monument and accessories and/or subsequent restoration:
1839 : GLO Survey by Lewis Clason - set post, referenced: 7" Maple - S44E - 15 / 11" W. pine - N54W - 11
1997: MDNR Survey by Carl Kiiskila - Found 3/8" rod in concrete monument, centerline road East, West, South on fence row to North

B. Description of corner evidence found and/or method applied in restoring or reestablishing corner:
1997: Found 3/8" bar in concrete monument in centerline of road E-W, 2' West of centerline road to South, on old fence line to North

This corner position is compatible with county & local surveys. This corner position is accepted as a careful and faithful perpetuation of the position of the original corner.

C. Description of monument for corner and accessories established to perpetuate locating the position of the corner:
1997: Placed 3" Alpena County cap stamped to identify the corner over 1/2" iron rod

Referenced:
S51W - 65.97' - Found tack w/flagging, set tag in 21" R. Pine
N52W - 45.95' - Found tack w/flagging, set tag in Power Pole
S59E - 113.15' - Set tag in Power Pole
N01E - 34.00' - Set tag in 7" Cedar Post

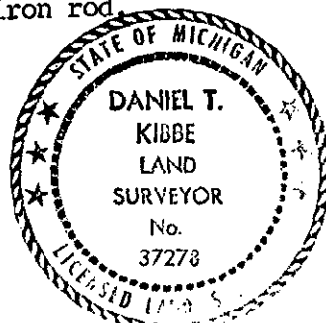

Signed by

Daniel T. Kibbe

Date October 24, 1997

Surveyor's Michigan License No. 37278