

SURVEY &  
REMONUMENTATION

FEB 03 1998 1997 Alpena County Remonumentation Corner

LAND CORNER RECORDATION CERTIFICATE  
Filing Requirement of Act 74, Mich. P.A. 1970

For corners in SECTION

Alpena

(County)

Located In:

Corner Code #

1. Public Land Survey

T29N R6E

L-7

T R

T R

T R

T R

2. Property Controlling  
in Section

S

T R

S

T R

3. Miscellaneous  
Property in Sec.

S

T R

S

T R

Liber 00002 Page 0120

STATE OF MICHIGAN

County of Alpena

Recorded

11-06-1997 15:31:51

Kathy J. Matash

REGISTER OF DEEDS

Register of Deeds Stamp & File Number

4. Lot No. , Recorded Plat  
5. Private Claims

I, Daniel T. Kibbe, in a field survey on March 27, 1997 do hereby state that under requirements of P.A. 74, Michigan P.A. of 1970, the corner points mentioned in lines 1 and 2 above were in conformance with regulations and rules therefore as required in the current manual of survey instructions of the United States Department of the Interior, Bureau of Land Management or by a decree of a Court of Law and/or that the corner points mentioned in lines 3, 4 and 5 above were in conformance with the rules of the Michigan Board of Land Surveyors or by a Decree of a Court of Law; established, re-established, monumented, recovered, found as expressed below:

NOTE: Not more than 2 corners, all in the same town and range, may be recorded on this certificate.

P.A. 345 ALPENA COUNTY

PEER APPROVED

7/13/97

*Daniel T. Kibbe*

A	B	C	D	E	F	G	H	I	J	K	L	M
1												
2	6		5		4		3		2		1	
3												
4	7		8		9		10		11		12	
5												
6	18		17		16		15		14		13	
7												
8	19		20		21		22		23		24	
9												
10	30		29		28		27		26		25	
11												
12	31		32		33		34		35		36	
13												

- A. Description of original monument and accessories and/or subsequent restoration:
- 1837: GLO survey by Lewis Clason - set  $\frac{1}{4}$  post, referenced: Beech 10"-N39E-17 / Beech 8" - S46W-52
- 1979: Survey by Duane R. MacNeill - set 1" pipe, referenced: N 05 E-33.36' - Fe. corner / S 20 W - 35.48' - Fe. post / N 40 E - 46.70' - Fe. post
- 1996: County Rd. Commission Survey by Gary St. Charles - Fd. existing 1" pipe w/cap, referenced: N09E-33.55'-Fe. corner / N52E-46.65'-Fe. post / S57E-66.25' - Fe. post.

B. Description of corner evidence found and/or method applied in restoring or reestablishing corner:

1997: Found 1" pipe and cap 1.5' North of E-W centerline and 1' West of N-S fence

This corner position is compatible with county & local surveys. This corner position is accepted as a careful and faithful perpetuation of the position of the original corner.

C. Description of monument for corner and accessories established to perpetuate locating the position of the corner:

1997: Placed 3" Alpena County cap stamped to identify the corner over  $\frac{1}{2}$ " iron rod.


Referenced:

N10E - 33.62' - fd. tag in Fence Post

N49E - 46.77' - fd. tag in Fence Post

S55E - 66.39' - fd. tag in Fence Post

S51W - 44.95' - set tag in Fence Post

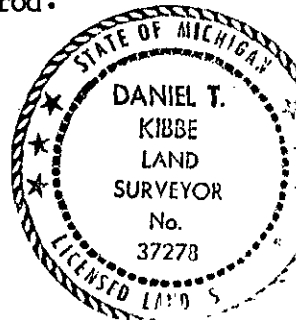

Signed by

*Daniel T. Kibbe*

Date

October 24, 1997

Surveyor's Michigan License No.

37278