

SURVEY & REMONUMENTATION

JAN 25 2001

2000 Alpena County Remonumentation

LAND CORNER RECORDATION CERTIFICATE Filing Requirement of Act 74, Mich. P.A. 1970

SECTION

For corners in

Alpena

(County)

Located In:

Corner Code #



L-2 P-311
08/14/2000 10:20A
Page: 1 of 1
LDC 9.00

Kathy J. Matash, Register Alpena Co., MI

1. Public Land Survey

T 30NR 07E

E-11

2. Property Controlling
in Section

S
S

T R
T R

3. Miscellaneous
Property in Sec.


S
S

T R
T R

4. Lot No. _____, Recorded Plat _____
5. Private Claims _____

I, Wayne T. Lewis, in a field survey on 2-24-00, 19X do hereby state that under requirements of P.A. 74, Michigan P.A. of 1970, the corner points mentioned in lines 1 and 2 above were in conformance with regulations and rules therefore as required in the current manual of survey instructions of the United States Department of the Interior, Bureau of Land Management or by a decree of a Court of Law and/or that the corner points mentioned in lines 3, 4 and 5 above were in conformance with the rules of the Michigan Board of Land Surveyors or by a Decree of a Court of Law; established, re-established, monumented, recovered, found as expressed below:

NOTE: Not more than 2 corners, all in the same town and range, may be recorded on this certificate.

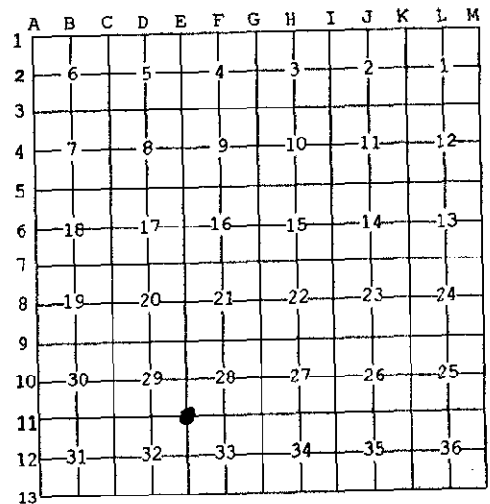

A. Description of original monument and accessories and/or subsequent restoration:

1839: Lewis Clason set post and witnessed.
1901: J. W. McNeil found large cedar stake in road, no witnesses given.
1908: J. W. McNeil found corner in road, no monumentation or witnesses given.

B. Description of corner evidence found and/or method applied in restoring or reestablishing corner:

Found large spike at surface, found 1/2" rod 0.8' below surface, set new 1/2" rerod in place of found rod where straight, in King Settlement Road C/L, 4' North of Dege Road C/L, and 4' South of old downed fence to the East.

This corner position is accepted as a careful and faithful perpetuation of the position of the original corner.

P.A. 345 ALPENA COUNTY
PEER APPROVED 7-12-2000
D.B. E

C. Description of monument for corner and accessories established to perpetuate locating the position of the corner:

2000: Placed 3" Alpena County Remonumentation Cap, stamped to identify the corner, on 1/2" rerod.

Witnesses:

N 35° E 39.81' 5" Ash (set tag #41922)
S 85° E 33.11' Exist. rerod w/cap #19237
South 189.25' 10" Ash (set tag #41922)
S 35° W 74.02' P. Pole (set tag #41922 over small disk and nail)



Signed by

[Signature]

Date August 14, 2000

Surveyor's Michigan License No. 41922