

DEC 4 2 24 PM '96

LAND CORNER RECORDATION CERTIFICATE
Filing Requirement of Act 74, Mich. P.A. 1970

Wanda R. Conway
REGISTER OF DEEDS

For corners in

(County)	Located in:	Corner Code #
1. Public Land Survey	T 30N R 9W	K-1
	T R	
	T R	
	T R	
2. Property Controlling in Section	S T R	
	S T R	
3. Miscellaneous Property in Sec.	S T R	
	S T R	

Register of Deeds Stamp & File Number

4. Lot No. _____, Recorded Plat _____
5. Private Claims _____

I, Terry B. Smith, in a field survey on Nov. 18, 1996 do hereby state that under requirements of P.A. 74, Michigan P.A. of 1970, the corner points mentioned in lines 1 and 2 above were in conformance with regulations and rules therefore as required in the current manual of survey instructions of the United States Department of the Interior, Bureau of Land Management or by a decree of a Court of Law and/or that the corner points mentioned in lines 3, 4 and 5 above were in conformance with the rules of the Michigan Board of Land Surveyors or by a Decree of a Court of Law; established, re-established, monumented, recovered, found as expressed below:

NOTE: Not more than 2 corners, all in the same town and range, may be recorded on this certificate.

A. Description of original monument and accessories and/or subsequent restoration:


GLO Ran North between Sections 1 & 2
set post common to sections 1 & 2
17 ch 48 lks east of old corner
Beech 10 S70E 11
Beech 10 S59W 45

B. Description of corner evidence found and/or method applied in restoring or reestablishing corner:

found 1/2" iron

C. Description of monument for corner and accessories established to perpetuate locating the position of the corner:

Set Antrim County Monument
Man Hole S40E 51.80
12" W. Pine S50W 82.90
20" Maple N20W 57.55
U.P. S50E 85.70

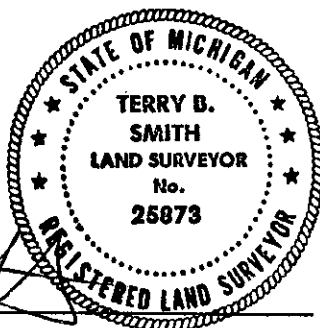

Ratified by Peer Group
in accordance with
PO 345.

Antrim County Chairman

Arthur L. Lennox
Arthur L. Lennox
Nov. 26, 1996

Signed by TB Smith
Surveyor's Michigan License No. 25873

Date Dec. 3, 1996

93

002 329