

DEC 10 1993

LIBER

1 PAGE 260

007559

RECORDED  
ALPENA COUNTY MI.1993 ~~COMMISSION~~ Alpena County Remonumentation Corner.LAND CORNER RECORDATION CERTIFICATE  
Filing Requirement of Act 74, Mich. P.A. 1970

DEC 1 3 16 PM '93

REGISTER OF DEEDS

For corners in

Alpena

(County)

Located In:

Corner Code :#

1. Public Land Survey T 32N R 8E A-5 (NW, 18)  
T \_\_\_\_\_ R \_\_\_\_\_ (Alpena Twp.)  
T \_\_\_\_\_ R \_\_\_\_\_  
T \_\_\_\_\_ R \_\_\_\_\_
2. Property Controlling S \_\_\_\_\_ T \_\_\_\_\_ R \_\_\_\_\_  
in Section S \_\_\_\_\_ T \_\_\_\_\_ R \_\_\_\_\_
3. Miscellaneous S \_\_\_\_\_ T \_\_\_\_\_ R \_\_\_\_\_  
Property in Sec. S \_\_\_\_\_ T \_\_\_\_\_ R \_\_\_\_\_
4. Lot No. \_\_\_\_\_, Recorded Plat \_\_\_\_\_
5. Private Claims \_\_\_\_\_

Register of Deeds Stamp &amp; File Number


I, Thomas L. Fabis, in a field survey on August 19, 19 93,  
do hereby certify that under requirements of P.A. 74, Michigan P.A. of 1970, the corner points mentioned  
in lines 1 and 2 above were in conformance with regulations and rules therefore as required in the  
current manual of survey instructions of the United States Department of the Interior, Bureau of Land  
Management or by a decree of a Court of Law and/or that the corner points mentioned in lines 3, 4 and 5  
above were in conformance with the rules of the Michigan Board of Land Surveyors or by a Decree of a  
Court of Law; established, re-established, monumented, re-monumented, recovered, found as  
expressed below:

NOTE: Not more than 4 corners, all in the same town and range, may be recorded  
on this certificate.

	A	B	C	D	E	F	G	H	I	J	K	L	M
2	6		5		4		3		2		1		
3													
4	7		8		9		10		11		12		
5													
6	18		17		16		15		14		13		
7													
8	19		20		21		22		23		24		
9													
10	30		29		28		27		26		25		
11													
12	31		32		33		34		35		36		
13													

- A. Description of original monument and accessories and/or subsequent restoration:
- 1855: G.L.O. Resurvey by Josiah Knauer - set post (Beech 24 N55W 40,  
Beech 12 S74W 37).
- 1890: County Survey by William H. LeRoy - Found Cedar stake 3" sq. in road  
(Beech stump 10 N47½E 54, Beech stump 24 N55W 40, Cedar stake 2" exist. 5
- 1893: County Survey by Fred A. Rice - Found stake and 3 witness stumps.
- 1904: County Survey by Jos. W. McNeil - Found Section Corner in Road.
- 1987: Recorded survey Liber 2 Pages 422 & 423 by David B. Guthrie - set ½"  
iron rod in centerline of Haken Road and established 3 witnesses.
- B. Description of corner evidence found and/or method applied in restoring or reestablishing corner:
- 1993: Found ½" iron rod in center of gravel road bed (Haken Road) opposite an  
old E-W fence line on East side of road as per recorded survey by David  
B. Guthrie and is accepted as a careful and faithful perpetuation of the  
position of the original corner.  
Also, found 3 witnesses (East - fence Post - 30.89 feet, S80°E - 3"  
Cherry - 75.40 feet, N30°E - Utility Pole - 87.13 feet) as per recorded  
survey Liber 2 Pages 422 & 423.  
The position of this corner is compatible with the old county surveys.
- C. Description of monument for corner and accessories established to perpetuate locating the position of the corner:
- 1993: Removed existing corner material and set ½" iron rod with 3" aluminum  
cap stamped to identify the corner.  
Reestablished witnesses are:

Exis tag #22435 in Utility Pole - N20°E - 87.15'  
Exis tag #22435 in 3" Cherry - S87°E - 75.43'  
Set tag #31591 in 6" Maple in Clump - N85°W - 511.45'  
Set tag #31591 in Utility Pole - S10°E - 304.88'

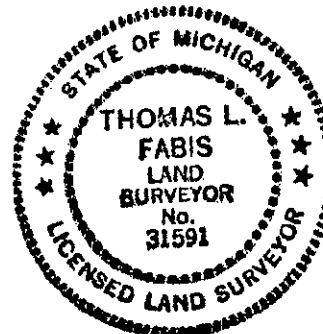

Signed by

Thomas L. Fabis

te

November 22, 1993

Surveyor's Michigan License No.

31591