

DEC 10 1993

1993 Alpena County Remonumentation Corner

COMMISSION

LAND CORNER RECORDATION CERTIFICATE

Filing Requirement of Act 74, Mich. P.A. 1970

DEC 1 3 16 PM '93

Myung A. Johnston
REGISTER OF DEEDS

For corners in

Alpena

(County)

Located In:

Corner Code #

1. Public Land Survey

T 32N R 8E

B-7 (S $\frac{1}{4}$, 18)
(Alpena Twp.)

T R

T R

T R

2. Property Controlling
in Section

S T R

S T R

3. Miscellaneous

S T R

Property in Sec.

S T R

Register of Deeds Stamp & File Number

4. Lot No. Recorded Plat

5. Private Claims

	A	B	C	D	E	F	G	H	I	J	K	L	M
2	6		5		4		3		2		1		
3													
4	7		8		9		10		11		12		
5													
6	13		17		16		15		14		13		
7													
8	19		20		21		22		23		24		
9													
10	30		29		28		27		26		25		
11													
12	31		32		33		34		35		36		
13													

I, Thomas L. Fabis, in a field survey on August 19, 19 93, do hereby certify that under requirements of P.A. 74, Michigan P.A. of 1970, the corner points mentioned in lines 1 and 2 above were in conformance with regulations and rules therefore as required in the current manual of survey instructions of the United States Department of the Interior, Bureau of Land Management or by a decree of a Court of Law and/or that the corner points mentioned in lines 3, 4 and 5 above were in conformance with the rules of the Michigan Board of Land Surveyors or by a Decree of a Court of Law; established, re-established, monumented, re-monumented, recovered, found as expressed below:

NOTE: Not more than 4 corners, all in the same town and range, may be recorded on this certificate.

A. Description of original monument and accessories and/or subsequent restoration:

1855: G.L.O. Resurvey by Josiah Knauer - set post(B. Ash 13 North 5, B. Ash 7 S19W 23).

1893: County survey by Fred A. Rice - Found G.L.O. corner.

1983: Unrecorded survey W.O. No. 004-83 by Gary St. Charles - found $\frac{1}{2}$ " iron rod (N10°W - 14" Maple - 39.11', S72°W - Power Pole - 82.46', S02°E - 4" Basswood - 40.59').

B. Description of corner evidence found and/or method applied in restoring or reestablishing corner:

1993: Found $\frac{1}{2}$ " iron rod 3' north of road centerline and one witness (S72°W - P. Pole - 82.46') as per unrecorded survey by St. Charles and is accepted as a careful and faithful perpetuation of the position of the original corner. The distances to the next section corners East and West of this corner checks with the St. Charles survey and fits proportionately with the County survey by Fred A. Rice.

C. Description of monument for corner and accessories established to perpetuate locating the position of the corner:

1993: Removed existing corner material and set $\frac{1}{2}$ " iron rod with 3" aluminum cap, stamped to identify the corner.


Reestablished witnesses are:

Exis. tag in P. Pole - S72°W - 82.46'

Set tag #31591 in 7" Maple - South - 44.59'

Set tag #31591 in 14" Maple - N20°W - 38.95'

Set tag #31591 in 9" Maple - N25°E - 38.18'

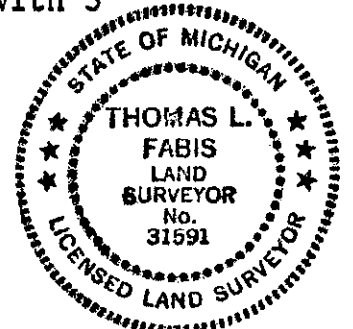

Signed by Thomas L. Fabis

Date November 22, 1993

Surveyor's Michigan License No. 31591