

MICHIGAN
DEPARTMENT OF CONSERVATION
FORESTRY DIVISION

LAND CORNER RECORD


T. 29N N.R. 4 W
T. 29N N.R. 5 W Otsego
Antrim COUNTY

DESCRIPTION OF CORNER 1/4 Corner common to Sections 18-13

CORNER MONUMENT Left 1/2" iron bar in place

DATE MONUMENT PLACED AND WITNESSED June 2, 1966

WITNESSES TO CORNER.....

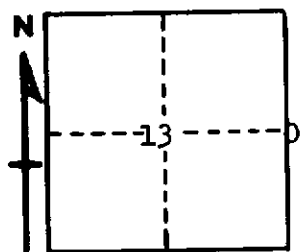

CIRCLE CORNER REGISTERED

7" Cedar N 30 E 22.1'

8" Cedar S 52 E 50.8

AND

DESCRIPTION IN DETAIL AS TO HOW CORNER WAS LOCATED AND IDENTIFIED OR RESTORED.

This corner was found while making a survey in this area. Found 1/2" iron bar buried below surface, probably set by G. F. DeLaMater. NW USBT stub in place showing good face and marks.

SURVEYOR'S SEAL

SIGNED *Kenneth J. Ostling* DATE June 9, 1966
REGISTERED LAND SURVEYOR #10068