

FEB 13 1999

189
Liber 00003 Page 0038

SECTION

LAND CORNER RECORDATION CERTIFICATE
Filing Requirement of Act 74, Mich. P.A. 1970

For corners in

Antrim Located In: Elk Corner Code #
(County) Rapids Twp.

1. Public Land Survey Sec. 29 T29NR9W Meander
T R
T R #2
T R
2. Property Controlling S T R
in Section S T R
3. Miscellaneous S T R
Property in Sec. S T R

ANTRIM COUNTY MI.
Register of Deeds
Recorded

12-28-1998 10:17:58

Manda R. Conway
REGISTER OF DEEDS

Register of Deeds Stamp & File Number

4. Lot No. , Recorded Plat
5. Private Claims

I, Neil L. Way, in a field survey on Dec. 16, 1998 do hereby state that under requirements of P.A. 74, Michigan P.A. of 1970, the corner points mentioned in lines 1 and 2 above were in conformance with regulations and rules therefore as required in the current manual of survey instructions of the United States Department of the Interior, Bureau of Land Management or by a decree of a Court of Law and/or that the corner points mentioned in lines 3, 4 and 5 above were in conformance with the rules of the Michigan Board of Land Surveyors or by a Decree of a Court of Law; established, re-established, monumented, recovered, found as expressed below:

NOTE: Not more than 2 corners, all in the same town and range, may be recorded on this certificate.

	A	B	C	D	E	F	G	H	I	J	K	L	M
1													
2		6		5		4		3		2		1	
3													
4		7		8		9		10		11		12	
5													
6		18		17		16		15		14		13	
7													
8		19		20		21		22		23		24	
9													
10		30		29		28		27		26		25	
11													
12		31		32		33		34		35		36	
13													

A. Description of original monument and accessories and/or subsequent restoration:

Dec. 1856- GLO set meander post on bank of Grand Traverse Bay
Apr. 1946- M. Feindt set concrete monument for plat of Pagel Pointe

B. Description of corner evidence found and/or method applied in restoring or reestablishing corner:

Found concrete monument as set by M. Feindt for plat of Pagel Pointe April 1946

Ratified by peer group
in accordance with
P.O. 345

Antrim Co. Chairman


Arthur L. Lennox

Arthur L. Lennox
Nov. 18, 1998

C. Description of monument for corner and accessories established to perpetuate locating the position of the corner:

Set Antrim County Monument at found concrete monument found 50'E of Grand Traverse Bay

S02°W 72.72' Oak 14"
S40°E 25.23' Oak 6"
N85°E 34.77' Oak 14"
N70°E 69.00' Red Pine 20"

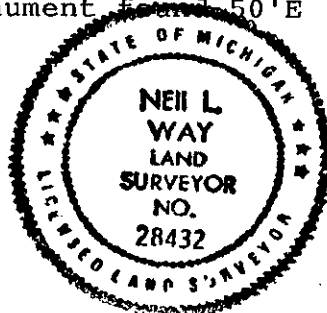

Signed by *Neil L. Way*
Surveyor's Michigan License No. 28432

Date Dec. 17, 1998