


LAND CORNER RECORDATION CERTIFICATE
Filing Requirement of Act 74, Mich. PA 1970

For Corners In:
Antrim Located In Corner Code #
(County)
1. Public Land Survey T 30 N R 6 W K 7
T 30 N R 6 W L 7
2. Property Controlling in Section S T R
S T R
3. Miscellaneous Property in Section S T R
S T R

4. Lot No: Recorded Plat:
5. Private Claims:

I, Carl T. Kiiskila, in a field survey on November 18, 2010 do hereby state that under requirements of PA 74, Michigan PA of 1970, the corner points mentioned in lines 1 and 2 above were in conformance with regulations and rules therefore as required in the current manual of survey instructions of the United States Department of the Interior, Bureau of Land Management or by a decree of a Court of Law and/or that the corner points mentioned in lines 3, 4 and 5 above were in conformance with the rules of the Michigan Board of Land Surveyors or by a Decree of a Court of Law; established, re-established, monumented, recovered, found as expressed below:
NOTE: Not more than 2 corners, all in the same town and range, may be recorded on this certificate.

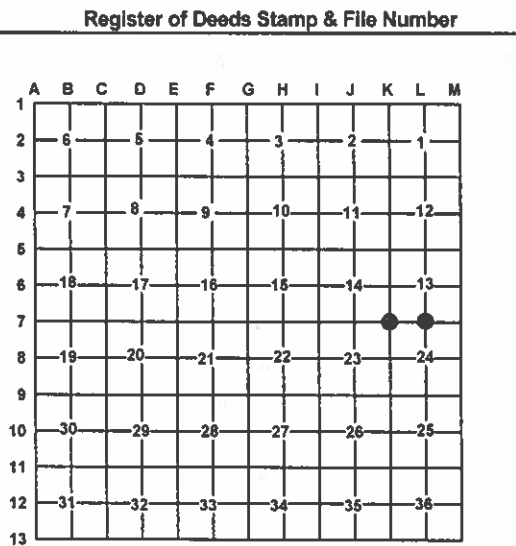

A. Description of original monument and accessories and/or subsequent restoration:
K-7 - Sec. Cor. comm. to sec.'s 13,14,23,24, T30N,R06W
1839 - GLO - James S. Mullet / N. Brevoart - Set post cor. Sect.'s 13,14,23,24 Sugar 13 S87°W 21 Birch 20 N43°E 31
1979 - L.C.R.C. - Carl F. Roser, P.S.#12028 - Accepted fd. conc. mon. as estab. By R.L.S., R. Findorff in 1969. 14" Maple N59°E 60.7' 5" Cherry S77°E 56.9' 8" Maple N02°E 76.6' Set Ced. Post w/Loc. tag.
L-7 - 1/4 Cor. comm. to sec.'s 13 & 24, T30N,R06W
1839 - GLO - James S. Mullet / N. Brevoart - Set 1/4 section post. Beech 8 N80°E 10 Beech 8 S64°E 19
1979 - L.C.R.C. - Carl F. Roser, P.S.#12028 - Accepted fd. conc. mon. as estab. By R.L.S., R. Findorff in 1969. 6" Maple S03°E 7.3' 8" Maple S75°W 14.4' 7" Maple N46°E 14.7' Added Cedar. Post w/Loc. tag. Ctr. N-S trail rd. W. 25'

B. Description of corner evidence found and/or method applies in restoring or re-establishing corner:
K-7 - Sec. Cor. comm. to sec.'s 13,14,23,24, T30N,R06W
Found 4" dia. concrete monument with 1/2" bar in center per L.C.R.C. by Carl F. Roser in 1979. Added 1/2" plastic P.S. cap #33981 on monument. Found all three of Roser's witnesses in good condition. Corner is 21' north of an E-W two track. Accepted found concrete monument as the best available evidence for the position of the original corner.
L-7 - 1/4 Cor. comm. to sec.'s 13 & 24, T30N,R06W
Found 4" dia. concrete monument with 1/2" bar in center per L.C.R.C. by Carl F. Roser in 1979. Added 1/2" plastic P.S. cap #33981 on monument. All three of Roser's witnesses were dead or gone. Found stump of 8" Maple to SW 14.6' away. Corner fall 9' west of potato field edge and 26.5' east of remains of N-S two track. Accepted found concrete monument as the best available evidence for the position of the original corner.

C. Description of monument for corner and accessories established to perpetuate locating the position of the corner:
K-7 - Sec. Cor. comm. to sec.'s 13,14,23,24, T30N,R06W
4" dia. conc. mon. with 1/2" plastic P.S. cap#33981
Wit: \*N53°E 61.05' to fd. nail on NW side 26" S. Maple \*S83°E 57.10' to fd. nail on S side 15" B. Cherry S45°W 71.31' to fd. nail on NW side 14" Basswood \*N03°W 76.80' to set N&T on E side 13" S. Maple Set Blue Carsonite Post w/ location tag 1' North
\* Witness of previous record.
L-7 - 1/4 Cor. comm. to sec.'s 13 & 24, T30N,R06W
4" dia. conc. mon. with 1/2" plastic P.S. cap#33981
Wit: S07°W 66.05' to set N&T on W side 5" B. Cherry S61°W 44.55' to set N&T on SE side 8" Elm N88°W 35.66' to set N&T on S side 22" S. Maple (scribed 'XBT') N10°W 60.50' to set N&T on E side 17" S. Maple (scribed 'XBT') Set Blue Carsonite post w/location tag 1' North.

Carl T. Kiiskila
Surveyor's Michigan License No.: 33981

