

SURVEY &  
REMONUMENTATION  
LAND CORNER RECORDATION CERTIFICATE

APR 26 1995 FILING REQUIREMENT OF ACT 74, MICH. P.A.1970

COMMISSION

FOR CORNERS OF--:	LOCATED IN--:	CORNER CODE NUMBER
1. PUBLIC LAND SURVEY <u>29</u> T. <u>30</u> N. <u>7</u> S. R. <u>7</u> E. W.		<u>E-10</u>
2. PROPERTY CONTROLLING IN SECTION _____ T. _____ N. _____ S. R. _____ E. _____ W.		
3. MISCELLANEOUS PROPERTY IN SECTION _____ T. _____ N. _____ S. R. _____ E. _____ W.		
4. LOT NO. _____, RECORDED PLAT _____		
5. PRIVATE CLAIMS _____		

ANTRIM COUNTY  
RECEIVED FOR RECORD  
DEC 5 2 06 PM '94  
REGISTER OF DEEDS  
Wanda R. Cavanaugh

REGISTER OF DEEDS STAMP AND  
FILING NUMBER

I, Terry B. Smith, do hereby certify that under requirements of P.A. 74, Michigan P.A. of 1970, the corner points mentioned in lines 1 and 2 above were, in a field survey on Nov. 23, 1994, established, re-established, monumented, re-monumented, recovered or restored as expressed below and in conformance with regulations and rules therefore as required in the current manual of survey instructions of the United States Department of the Interior, Bureau of Land Management or by a decree of a court of law. Furthermore, that the corner points mentioned in lines 3, 4 and 5 above were, in a field survey on Nov. 23, 1994, found, recovered, restored, established or re-established as expressed below and in conformance with the rules of the Michigan State Board of Registration for Land Surveyors or, by a Decree of a Court of law:

A. Description of original monument and accessories and/or subsequent restoration:

GLO Corner Post Oct. 1855

Beech 8 N53E 17  
Beech S63W 32

Aug. 1886 County Surveyor Fredric Church found one witness and stump of othe marked pine stump 40 S34E 22  
No evidence found

No evidence found

Corner set by LS#20703 Wayne Boss using bearing & distance from previous surveys Jan. 1976

B. Description of corner evidence found and/or method applied in restoring or re-establishing corner:

found  $\frac{1}{2}$ " iron bar & witnesses

C. Description of monument for corner and accessories established to perpetuate locating the position of the corner:

E-10 -- E1 Corne Sec. 29, T30N, R7W  
Peer group approval Oct. 6, 1994  
Set Antrim County Monument  
5" Elm S30°E 20.7  
8" Basswood N40°W 11.1  
12" Basswood N10°W 16.3  
18" Basswood N40°E 16.3

Ratified by Peer Group  
in accordance with P.A. 345  
Chairman Arthur L. Lennox  
Date: Oct. 6, 1994

SIGNED BY Terry B. Smith DATE NOV. 30 1994

SURVEYOR'S MICHIGAN REGISTRATION NO. 25873


FOR STATE AND UNITED STATES AGENCIES:

SIGNED BY \_\_\_\_\_ DATE \_\_\_\_\_

CHIEF OF SURVEY PARTY

APPROVED AND SIGNED BY \_\_\_\_\_ DATE \_\_\_\_\_

MICHIGAN REGISTERED LAND SURVEYOR

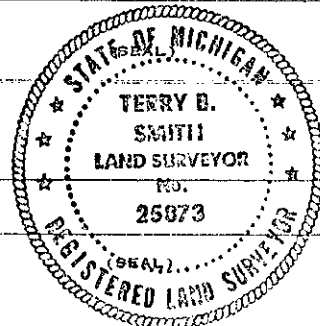

002 219  
SURVEYOR'S MICHIGAN REGISTRATION NO. \_\_\_\_\_