

COMMISSION

# Arenac County Remonumentation

## LAND CORNER RECORDATION CERTIFICATE Filing Requirement of Act 74, Mich. P.A. 1970

LIBER 002 PAGE 091

For corners in

Arenac (County)	Located in:	Corner Code #
1. Public Land Survey	T18N R 4E	E-8
	T R	
	T R	
	T R	
2. Property Controlling in Section	S T R	
	S T R	
3. Miscellaneous Property in Sec.	S T R	
	S T R	

RECORDED  
JAN 2 11 15 AM '97  
ARENAC COUNTY  
REGISTER OF DEEDS

Register of Deeds Stamp & File Number

4. Lot No. \_\_\_\_\_, Recorded Plat \_\_\_\_\_  
5. Private Claims \_\_\_\_\_

I, Michael J. MacDonald, in a field survey on July 19, 1996 do hereby state that under requirements of P.A. 74, Michigan P.A. of 1970, the corner points mentioned in lines 1 and 2 above were in conformance with regulations and rules therefore as required in the current manual of survey instructions of the United States Department of the Interior, Bureau of Land Management or by a decree of a Court of Law and/or that the corner points mentioned in lines 3, 4 and 5 above were in conformance with the rules of the Michigan Board of Land Surveyors or by a Decree of a Court of Law; established, re-established, monumented, recovered, found as expressed below:

NOTE: Not more than 2 corners, all in the same town and range, may be recorded on this certificate.

	A	B	C	D	E	F	G	H	I	J	K	L	M
1													
2	6		5		4		3		2		1		
3													
4	7		8		9		10		11		12		
5													
6	10		17		16		15		14		13		
7													
8	19		20		21		22		23		24		
9													
10	30		29		28		27		26		25		
11													
12	31		32		33		34		35		36		
13													


A. Description of original monument and accessories and/or subsequent restoration:  
E-8 Post set by J. Burt in 1843.

MDOT Witness Card - L 1, P. 205, G. Slattery set 3/4" pipe half way and on line between E-7 and E-9 in October 1963.

MDOT Witness Card - L 1, P. 208, N. Caldwell in April 1964 and 3/4" pipe set by G. Slattery.

B. Description of corner evidence found and/or method applied in restoring or reestablishing corner:

E-8 No monument or witness fnd.  
Set on line and midway between E-7 and E-9 and is accepted as the best available evidence of the position of the original corner.  
Meas 5263.68' between E-7 and E-9 (5262.76' - MDOT).

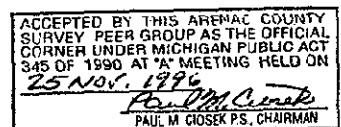

C. Description of monument for corner and accessories established to perpetuate locating the position of the corner:

E-8 Set 5/8" x 24" rebar with Arenac County Remonumentation cap in monument box.

S 50° E 105.66' to nail and tag in N face of 6" Pine.  
N 02° E 222.60' to nail and tag in top of S guard rail post on W side of Melita Road.  
N 20° E 162.76' to nail and tag in top of S guard rail post on E side of Melita Road.  
E 7.3' to centerline Melita Road pavement.  
S 15° W 92.52' to set 3/8" Iron and cap #18999.



Signed by Michael J. MacDonald  
Surveyor's Michigan License No. 22438

Date 19 Dec 96