

SURVEY &
REMONUMENTATION

MAR 05 1998

SECTION

ARENAC COUNTY REMONUMENTATION
LAND CORNER RECORDATION CERTIFICATE
Filing Requirement of Act 74, Mich. P.A. 1970

For corners in

<u>Arenac</u> (County)	Located In:	Corner Code #
1. Public Land Survey	T18N R4E	K-7
	T R	
	T R	
	T R	
2. Property Controlling in Section	S T R	
3. Miscellaneous Property in Sec.	S T R	
	S T R	
4. Lot No. _____, Recorded Plat _____		
5. Private Claims _____		

Page 1 of 1
ROSE SMITH
ARENAC CO. REG. OF DEEDS
RS Rec. Date 12/23/97 Time 11:39
RECORDING FEES: 9.00
LC 2/ 131
1P

Register of Deeds Stamp & File Number

	A	B	C	D	E	F	G	H	I	J	K	L	M
1													
2	6		5		4		3		2		1		
3													
4	7		8		9		10		11		12		
5													
6	18		17		16		15		14		13		
7													
8	19		20		21		22		23		24		
9													
10	30		29		28		27		26		25		
11													
12	31		32		33		34		35		36		
13													


I, MICHAEL J. MACDONALD, in a field survey on SEPTEMBER 12, 1997
do hereby state that under requirements of P.A. 74, Michigan P.A. of 1970, the corner points
mentioned in lines 1 and 2 above were in conformance with regulations and rules therefore as
required in the current manual of survey instructions of the United States Department of the Interior,
Bureau of Land Management or by a decree of a Court of Law and /or that the corner points
mentioned in lines 3, 4 and 5 above were in conformance with the rules of the Michigan Board of
Land Surveyors or by a Decree of a Court of Law; established, re-established, monumented,
recovered, found as expressed below:

NOTE: Not more than 2 corners, all in the same town and range, may be recorded
on this certificate.

A. Description of original monument and accessories and/or subsequent restoration:

K-7

- ORIGINAL POST SET IN JULY 1843 BY J. BURT D.S.
W. PINE 40" S 47°W 17 LKS.
W. PINE 13" N 2½°E 9 LKS.
- COUNTY SURVEYOR NOTES OCTOBER 1915, FOUND SMALL CEDAR POST WITH BOTTLES AROUND.
- LCRC, L.1, P. 188, N. CALDWELL (1964)
FOUND A SMALL BOAT SPIKE (PLACE STEEL FENCE POST ALONG SIDE)
N 33°E 65.11' POWER POLE
S 54° E 51.46' TELEPHONE POLE
S 26°W 131.91' NE COR OF HOUSE
- SURVEY, L. 1, P. 326, MCGINNIS (1977)
FOUND SMALL BOAT SPIKE
N 33°E 65.11' TO POWER POLE
S 54°E 51.46' TO TELEPHONE POLE
S 26°W 131.91' TO NE HSE. COR.
- SURVEY, L. 1, P. 665, MCGINNIS (1990)
FND 5/8" ROD
NE 59.12' TO MDOT TAG IN W. SIDE OF UTILITY POLE
ESE 51.38' TO PK NAIL IN SW SIDE OF UTILITY POLE
NW 61.61' TO NAIL IN SOUTH SIDE OF 10" ASH
SW 132.1 TO NE COR. FOUNDATION
- LCRC, L. 2, P.108, KOCH, 1997 FND 1/2" IRON OVER FENCE POST
N 33°E 59.12' FND N/T W FACE POWER POLE
S 60°E 51.38' FOUND PK SW SIDE CUTOFF POWER POLE
S 26° W 131.91' NE COR FOUNDATION HOUSE #3509
N 85°W 1.61' SMALL BOAT SPIKE
NW TO NAIL IN SOUTH SIDE 10" ASH

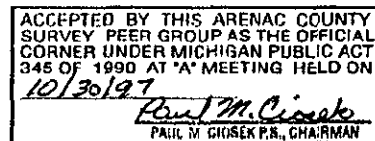

B. Description of corner evidence found and/or method applied in restoring or reestablishing corner:

K-7

SEARCHED THE LOCATION OF 1/2" REROD, FOUND FENCE POST (LEANING) AT ±1.5' DEEP (12" GRAVEL), STOPPED DIGGING AT 24"
DEEP STILL IN SAND. NO OTHER OBJECTS IN HOLE. BOAT SPIKE 1.6' WESTERLY NOTHING FOUND UNDER IT, RESET IT. DISTANCE FROM
1/2" REROD TO J-7 FIT DISTANCE ON LCRC L1, P. 188 (2634.19' M., 2634.24' R.). ACCEPTED THE 1/2" REROD AS THE BEST AVAILABLE
EVIDENCE OF THE POSITION OF THE ORIGINAL CORNER.

C. Description of monument for corner and accessories established to perpetuate locating the position of the corner:

K-7


REPLACED FOUND 1/2" REROD WITH 5/8" x 24" LONG REROD WITH ARENAC CO. REMONUMENTATION CAP WITH 1/8" DRILL HOLE.
N 33°E 59.15' (59.12' R.) FND N/T W FACE POWER POLE
S 60°E 51.39' (51.38' R.) FOUND PK SW SIDE CUTOFF POWER POLE
S 5°W 51.35' FOUND MDOT TAG E. FACE TWIN 14" BOX ELDER
S 26° W 131.92' (131.91' R.) NE COR FOUNDATION HOUSE #3509
N 85°W 1.60' (1.61' R.) SMALL BOAT SPIKE
±1.0' W OF CENTER LINE OF EAST CITY LIMITS ROAD
±.5' S. OF CENTER LINE OF SAGATOO ROAD

Signed by

Michael J. MacDonald

Surveyor's Michigan License No. 22438

FIELD BOOK 2, PAGE 43

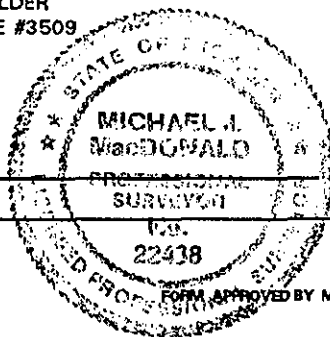

Date

22 Dec 97