

SURVEY & REMONUMENTATION

MAR 05 1998

SECTION

ARENAC COUNTY REMONUMENTATION  
LAND CORNER RECORDATION CERTIFICATE  
Filing Requirement of Act 74, Mich. P.A. 1970

For corners in

ARENAC  
(County)

Located in:

Corner Code # Page 1 of 1  
ROSE SMITH

LC 2/ 141  
1P

1. Public Land Survey

T18N R4E

K-9

ARENAC CO. REG. OF DEEDS  
RS Rec. Date 12/23/97 Time 11:44  
RECORDING FEES: 9.00

2. Property Controlling  
in Section

S T R  
S T R

3. Miscellaneous  
Property in Sec.

S T R  
S T R

Register of Deeds Stamp & File Number

4. Lot No. , Recorded Plat

5. Private Claims

I, MICHAEL J. MACDONALD, in a field survey on OCTOBER 23, 1997 do hereby state that under requirements of P.A. 74, Michigan P.A. of 1970, the corner points mentioned in lines 1 and 2 above were in conformance with regulations and rules therefore as required in the current manual of survey instructions of the United States Department of the Interior, Bureau of Land Management or by a decree of a Court of Law and /or that the corner points mentioned in lines 3, 4 and 5 above were in conformance with the rules of the Michigan Board of Land Surveyors or by a Decree of a Court of Law; established, re-established, monumented, recovered, found as expressed below:

NOTE: Not more than 2 corners, all in the same town and range, may be recorded on this certificate.

	A	B	C	D	E	F	G	H	I	J	K	L	M
1													
2		6		5		4		3		2		1	
3													
4		7		8		9		10		11		12	
5													
6		18		17		16		15		14		13	
7													
8		19		20		21		22		23		24	
9													
10		30		29		28		27		26		25	
11													
12		31		32		33		34		35		36	
13													

A. Description of original monument and accessories and/or subsequent restoration:

K-9

1. ORIGINAL POST SET JULY 1843 BY J. BURT D.S.  
HEMLOCK 14" N 44°W 15 LINKS  
MAPLE 12" S 37 1/2°E 27 LINKS
2. COUNTY SURVEYOR NOTES, 1912, SET POST
3. COUNTY SURVEYOR NOTES, 1915, RESURVEYED AND HELD OLD POST SAID TO BE THE ORIGINAL POST.
4. SURVEY, L. 2, P. 155, MCGINNIS, 1995, FND 1/2" REROD PS14097  
N 10°W 42.10' FND N/T IN GATE  
N 35°E 53.76' PK IN 6" POPLAR  
S 50° E 62.22' PK 6" MAPLE  
S 45°W 36.74' PK 8" MAPLE
5. SURVEY. KOBBS, L. 2, P. 128, FND BAR, NO WIT.

B. Description of corner evidence found and/or method applied in restoring or reestablishing corner:

K-9


SEARCHED THE APPARENT LOCATION OF THE CORNER AND FOUND A 1/2" REROD PS 14097. DISTANCE RECORDED TO L-9 2598.65', DISTANCE MEASURED TO L-9 2598.61'. DISTANCE MEASURED TO K-10 IS 2569.76' AND THE DISTANCE MEASURED IN THE 1915 COUNTY SURVEYORS NOTES WAS 39 CHAINS (2574'). ACCEPTED THE CAPPED 1/2" REROD AS THE BEST AVAILABLE EVIDENCE OF THE POSITION OF THE ORIGINAL CORNER.

C. Description of monument for corner and accessories established to perpetuate locating the position of the corner:

K-9

REPLACED THE CAPPED 1/2" REROD WITH 5/8" REROD x 24" LONG REROD WITH ARENAC CO. REMONUMENTATION CAP WITH 1/8" DRILL HOLE.  
N 10°W 42.10' (42.04' R.) FND N/T IN WOOD GATE POST  
N 35°E 53.91' (53.76' R.) PK IN 6" POPLAR  
S 50° E 62.22' (M. & R.) FND PK IN 6" MAPLE  
S 45°W 36.74' (M. & R.) FND PK IN 8" MAPLE  
SOUTH 31.22' SET N/T W. FACE FENCE POST

Signed by Michael J. MacDonald  
Surveyor's Michigan License No. 22438  
FIELD BOOK 2, PAGE 53

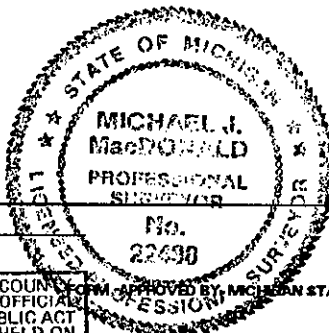

Date 12 Dec 97

ACCEPTED BY THIS ARENAC COUNTY SURVEY PEER GROUP AS THE OFFICIAL CORNER UNDER MICHIGAN PUBLIC ACT 345 OF 1990 AT A MEETING HELD ON 10/30/97  
Paul M. Cissak  
NORTH 44° 00' 00" E 100.00' 00" S 100.00' 00" E 44° 00' 00" N

APPROVED BY MICHIGAN STATE BOARD OF PROFESSIONAL SURVEYORS, JAN. 28, 1971  
REVISED MAY 14, 1975  
REVISED JAN., 1983  
REVISED OCT., 1985