

ARENAC COUNTY REMONUMENTATION
LAND CORNER RECORDATION CERTIFICATE
Filing Requirement of Act 74, Mich. P.A. 1970

REMONUMENTATION

For corners in

JAN 25 2000

ARENAC COUNTY
(County)

Located In:

Corner Code #

SECTION

1. Public Land Survey

T 18N R 5E

E-8

T R

T R

T R

S T R

2. Property Controlling
in Section

S T R

S T R

3. Miscellaneous
Property in Sec.

S T R

S T R

Page 1 of 1

ROSE SMITH

ARENAC CO. REG. OF DEEDS

RS Date 01/06/2000

RECORDING FEES:

LC 2/214

1P

Time 10:12:58

9.00

Register of Deeds Stamp & File Number

4. Lot No. , Recorded Plat

5. Private Claims

I, DALE L. WINIECKE, in a field survey on NOVEMBER, 1999 do hereby state that under requirements of P.A. 74, Michigan P.A. of 1970, the corner points mentioned in lines 1 and 2 above were in conformance with regulations and rules therefore as required in the current manual of survey instructions of the United States Department of the Interior, Bureau of Land Management or by a decree of a Court of Law and /or that the corner points mentioned in lines 3, 4 and 5 above were in conformance with the rules of the Michigan Board of Land Surveyors or by a Decree of a Court of Law; established, re-established, monumented, recovered, found as expressed below:

NOTE: Not more than 2 corners, all in the same Town and Range, may be recorded on this certificate.

	A	B	C	D	E	F	G	H	I	J	K	L	M
1													
2	6			5			4			3		2	1
3													
4	7			8			9			10		11	12
5													
6	18			17			16			15		14	13
7													
8	19			20			21			22		23	24
9													
10	30			29			28			27		26	25
11													
12	31			32			33			34		35	36
13													

A. Description of original monument and accessories and/or subsequent restoration:

E-8

POST SET BY J. BURT, JULY 1843
10" BLACK ASH EAST 18 LINKS
5" BLACK ASH N74 1/2°W 21 LINKS

L.C.R.C., L. 1, P. 134, LEONARD URBANIAK, PS# 14469, JUNE 1979, SET CAPPED 1/2" REROD
CERTIFICATE OF SURVEY, L.1, P. 554, PAUL CIOSEK, PS#25835, JUNE 1986, NO CALL
CERTIFICATE OF SURVEY, L.2, P. 25-26, LLOYD MCGINNIS, PS#18999, AUGUST 1992, FOUND BENT 3/8" REROD WITH CAP, RESET

B. Description of corner evidence found and/or method applied in restoring or reestablishing corner:

E-8

SEARCHED THE APPARENT LOCATION OF THE CORNER AND FOUND A 3/8" REROD WITH CAP # 18999.
CHECKED WITNESSES FROM L.C.R.C. L. 1, P.134, S35°E TO TELEPHONE POLE 47.36' (R) TO NAIL & TAG IN NORTHEAST FACE OF U.POLE 47.26' (M), S55°E TO 24" WILLOW 67.35' (R) TO CAPPED NAIL & TAG IN S'LY FACE 36" WILLOW 67.90' (M);
CHECKED WITNESSES FROM CERTIFICATE OF SURVEY L. 1, P. 554, WEST TO WEST END OF CMP 11.7' (R) ,11.73' (M), S35°E TO TELEPHONE POLE 47.0'(R) TO NORTHWEST FACE U. POLE, 46.93' (M);
EXCAVATED POINT AND FOUND NO OTHER MONUMENTATION
THE 3/8" CAPPED REROD WAS ACCEPTED AS THE BEST EVIDENCE OF THE POSITION OF THE ORIGINAL CORNER.

C. Description of monument for corner and accessories established to perpetuate locating the position of the corner:


E-8

REPLACED THE CAPPED 3/8" REROD WITH 5/8"x 24" LONG REROD WITH ARENAC COUNTY REMONUMENTATION CAP.
S86°E 20.39' TO PK NAIL IN E'LY END 36" CMP
N85°W 11.57' TO PK NAIL IN W'LY END 36" CMP
S40°W 41.3' TO CHISELED "X" IN IRON BEAM
N60°E 70.76' TO PK IN NW FACE 10" ASH
EAST ± 5' TO PHYSICAL CENTERLINE OF LACLAIR ROAD

Signed by Dale Winiecke

Surveyor's Michigan License No. 41915

Date 12/30/99

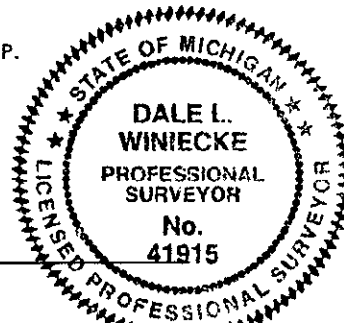

FB 4, P. 7

FORM APPROVED BY MICHIGAN STATE BOARD OF PROFESSIONAL SURVEYORS, JAN. 28, 1971

REVISED MAY 14, 1976
REVISED JAN., 198
REVISED OCT., 199

