

LAND CORNER RECORDATION CERTIFICATE

Filing Requirement of Act 74, Mich. PA 1970

For Corners In:

Arenac
(County)

Located In

Corner Code #



201600539

DOC#: 201600539

February 29, 2016 10:45 AM

Fee: \$14.00

Darlene Mikkola
Register of Deeds
Arenac County, MI

Page 1 of 1 CD

1. Public Land Survey

T 20N R 05E C10

2. Property Controlling
in Section

S T R

S T R

3. Miscellaneous
Property in Section

S T R


S T R

4. Lot No: Recorded Plat:

5. Private Claims:

I, Joshua R. Davidson, in a field survey on October 29, 2014 do hereby state that under requirements of PA 74, Michigan PA of 1970, the corner points mentioned in lines 1 and 2 above were in conformance with regulations and rules therefore as required in the current manual of survey instructions of the United States Department of the Interior, Bureau of Land Management or by a decree of a Court of Law and/or that the corner points mentioned in lines 3, 4 and 5 above were in conformance with the rules of the Michigan Board of Land Surveyors or by a Decree of a Court of Law; established, re-established, monumented, recovered, found as expressed below:

NOTE: Not more than 2 corners, all in the same town and range, may be recorded on this certificate.

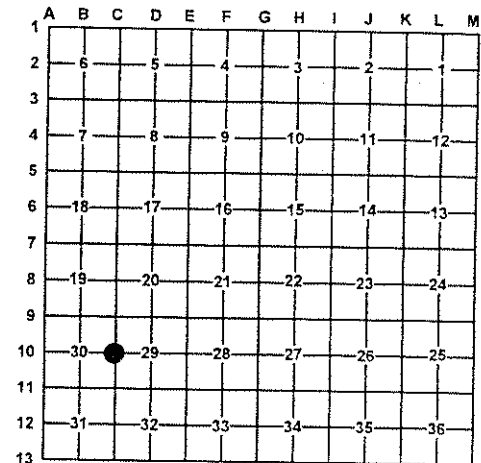

A. Description of original monument and accessories and/or subsequent restoration:

C10 – 1/4 corner common to sections 29 & 30, T20N, R5E

- 1846 – GLO – B. F. Hall – set 1/4 section post – 1) White Pine 12 N43°W 15; 2) Maple 6 S52°E 27.
- 1983 – Certificate of Survey, L. 1, p. 491, R. Miller PS # 16050. No corner description, shown at single proportionate distance.
- 1987 – field notes – Farrier Surveying – 30|29 ¼ corner, T20N, R5E – Set iron & cap at S.P. position.

B. Description of corner evidence found and/or method applied in restoring or re-establishing corner:

C10 – 1/4 corner common to sections 29 & 30, T20N, R5E

Found ½" rebar & cap #24594 set by single proportion using a 2" pipe for the corner C11. Found and held the 1957 MDOT position of C11. Therefore, did not accept the position of found ½" rebar & cap. Set a stamped 4" DNR aluminum cap on 1" x 36" galvanized iron pipe at single proportionate distance between C9 and C11. S58°51'W 18.24' to found ½" rebar & cap #24594 not utilized in this survey. 4" DNR aluminum cap on 1" x 36" galvanized iron pipe is accepted as a careful and faithful reestablishment of the position of the original corner.

C. Description of monument for corner and accessories established to perpetuate locating the position of the corner:

C10 – stamped 4" DNR aluminum cap on 1" x 36" galvanized iron pipe.

N20°E 39.64' to set nail & tag in west side 6" White Pine
S24°E 44.09' to set nail & tag in east side 13" White Pine
S32°W 21.27' to set nail & tag in southeast side twin 10" & 16" Oak
S58°51'W 18.24' to found ½" rebar & cap #24594
Set Blue post 1' north

Signed by:

Joshua R. Davidson

Date: February 24, 2016

Surveyor's Michigan License No.: 46659

