

LAND CORNER RECORDATION CERTIFICATE
Filing Requirement of Act 74, Mich. P.A. 1970

For corners in

Baraga

(County)

Located In:

Corner Code #

1. Public Land Survey

T 47N R 33W

MC north of E6

T 47N R 33W

A3

T R

T R

2. Property Controlling
in Section

S

T R

S

T R

3. Miscellaneous
Property in Sec.

S

T R

S

T R

Register of Deeds Stamp & File Number

4. Lot No. , Recorded Plat

5. Private Claims

A3 Jan 07 2003

MC Jan 02 2003

I, Stephan J. Szyszkoski, in a field survey on _____, 20____ do hereby state that under requirements of P.A. 74, Michigan P.A. of 1970, the corner points mentioned in lines 1 and 2 above were in conformance with regulations and rules therefore as required in the current manual of survey instructions of the United States Department of the Interior, Bureau of Land Management or by a decree of a Court of Law and /or that the corner points mentioned in lines 3, 4 and 5 above were in conformance with the rules of the Michigan Board of Land Surveyors or by a Decree of a Court of Law; established, re-established, monumented, recovered, found as expressed below:

NOTE: Not more than 2 corners, all in the same town and range, may be recorded on this certificate.

	A	B	C	D	E	F	G	H	I	J	K	L	M
1													
2		6		5		4		3		2		1	
3													
4		7		8		9		10		11		12	
5													
6		18		17		16		15		14		13	
7													
8		19		20		21		22		23		24	
9													
10		30		29		28		27		26		25	
11													
12		31		32		33		34		35		36	
13													

A. Description of original monument and accessories and/or subsequent restoration:

(MC north of E6) Meander corner on the south shore of Drummond Lake between Sections 16 and 17. 1852: Established by Francis Houck: Over lake and set meander post. Tam 8 N36W 8 links, Spruce 8 S78E 13 links. 1954: Record of Northern Paper Mills states "Wickman and Peryan found post, stake in down tam. Iron marks faint. Set pipe from stump. Lake seems to have receded somewhat". Set Pipe/brass cap. No witnesses.

(A3) Corner common to Sections 6-7 T47N-R33W and 1-12 T47N-R34W. 1994: Rewitnessed and recorded by the undersigned. Found 1"ID iron pipe with 4" brass cap at record bearing and distance from 2 1954 NBTs (10" Hemlock N65E 29 links, 10" Y.Birch S14W 42 links). 1994 NBTs: 5" Sugar S35E 23.3', 12" Y.Birch N12W 11.7'.

B. Description of corner evidence found and/or method applied in restoring or reestablishing corner:


(MC north of E6) Recovered the 1954 monument in good condition approx. 85' south of the edge of vegetation at the shoreline of Drummond Lake. Found squared cedar post adjacent. Accepted the monument as a careful and faithful perpetuation of the position of the original corner.

(A3) Recovered the monument as described, in good condition, and at record bearing and distance from the 1954 and 1994 NBTs. Also recovered remains of the original BTs Hemlock 8 S37W 32, and W.Pine 34 N45E 12 at record bearing and distance. The 1994 5" Sugar is dead and down. The 1954 10" Y.Birch was cut to facilitate GPS observations. Marked two additional bearing trees as described below.

C. Description of monument for corner and accessories established to perpetuate locating the position of the corner:

(MC) Found 1"ID iron pipe with 2" brass Northern Paper Mills cap. Set nails with tags in the following:
2" B.Spruce S45E 6.45' (no markings)
2" B.Spruce S11W 20.7' do
Set new sq'd cedar post 0.5' easterly.
No other witnesses available.

(A3) Found 1"ID iron pipe with 4" brass cap. Blazed, scribed, and set measuring nails in:
13" Hemlock S82E 28.1' "S7 NBT"
14" Hemlock S17E 63.7' do
Distances are to nails with tags.
Distances to 1954 and 1994 NBTs noted above are to measuring notch. Bearings magnetic. Set sq'd cedar post N65E 7 ft. distant.

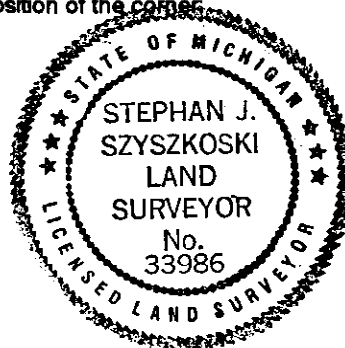

Signed by Stephan J. Szyszkoski
Surveyor's Michigan License No. 33986

Date 7/16/03