

LAND CORNER RECORDATION CERTIFICATE


Authority: 1970 PA 74, MCL 54.205

Surveyor's Name: Stephan J. Szyszkoski

Field Survey Date: September 20, 2016

For corner(s) in: Baraga County

Original Public Land Survey Corner				Corner Code
S		T	R	
S		T	R	
S		T	R	
S		T	R	
Property Corner				1/16 Corner Code
a. S	15	T	48N R 32W	15 (GCDB 420400)
a. S	22	T	48N R 32W	1 (GCDB 420400)
b. S	15	T	48N R 32W	10 (GCDB 400420)
b. S	16	T	48N R 32W	14 (GCDB 400420)

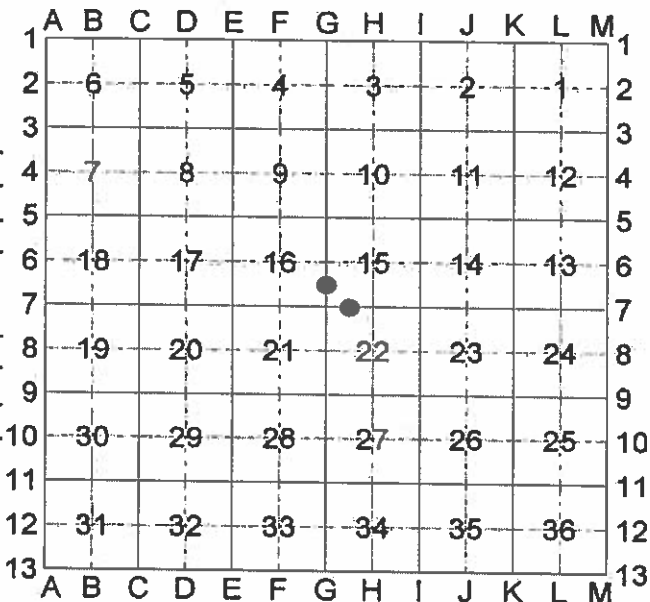

Part A. Corner History

- a.) West 1/16 corner between Sections 15 and 22. Not previously monumented.
- b.) South 1/16 corner between Sections 15 and 16. Not previously monumented.

Part B: Surveyor's Report on Perpetuation, Restoration, Reestablishment, or Monumentation of Corner

- a.) Established the position for the corner midway and on the Section line between Section corner 1330.69' west and Quarter corner 1330.69' east.
- b.) Established the position for the corner midway and on the Section line between Section corner 1318.38' south and Quarter corner 1318.38' north.

Part C: Field Evidence of Perpetuation or Monumentation of Corner

(a.) Set 1"IDx28" I.pipe with 2" alum. MDNR cap.
Set measuring nail with MDNR tag in the side of:
15" Spruce N38°W 10.9' mrkd "1/16S BT"
3" Balsam N88°E 8.9' do
5" Balsam S31°E 15.15' do
7" Maple S66°W 25.9' do
Set sq'd cedar post adjacent.
E= 7900407.68 N= 197148.04

(b.) Set 1"IDx28" I.pipe with 2" alum. MDNR cap.
Set measuring nail with MDNR tag in the side of:
13" Maple N12°W 23.4' mrkd "1/16S BT"
17" Maple N61°E 14.2' do
5" Maple S24°W 10.5' do
24" Sugar N82°W 20.25' do
Set sq'd cedar post adjacent.
E= 7900009.98 N= 197558.73

Bearings are magnetic. Coordinates are MCS83, NAD83(2011) Epoch 2010.00, in meters.
Coordinate Reference: NGS PID RL1468, E= 7900599.998 m. N= 199449.725 m.

Stephan J. Szyszkoski 10/20/2016

