

LAND CORNER RECORDATION CERTIFICATE

Authority: 1970 PA 74, MCL 54.205

Surveyor's Name: Stephan J. Szyszkoski

Field Survey Date: See below

For corner(s) in: Baraga County

Original Public Land Survey Corner

a. S T 49N R 33W
b. S T 49N R 33W
S T R
S T R

Corner Code


J07 (GCDB 540400)

K06 (GCDB 600440)

Property Corner

S T R
S T R
S T R
S T R

1/16 Corner Code

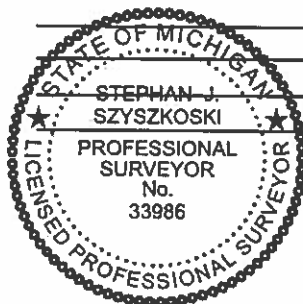

1	A	B	C	D	E	F	G	H	I	J	K	L	M	1
2		6		5		4		3		2		1		2
3														3
4		7		8		9		10		11		12		4
5														5
6		18		17		16		15		14	●	13		6
7										●				7
8		19		20		21		22		23		24		8
9														9
10		30		29		28		27		26		25		10
11														11
12		31		32		33		34		35		36		12
13	A	B	C	D	E	F	G	H	I	J	K	L	M	13

Part A: Corner History

a.) Quarter corner common to Sections 14 and 23. 1852 - Established by Z.B.Searles, Deputy, midway and on the Section line between Section corners 40.00 chains east and west. Set post. Hemlock 12" S66°E 11 links, Maple 14" N32°W 22 links. 1947 - Norman T. Thompson RLS recovered the original BTs (noted as "OK") and set a Cedar post at the corner position. No other witnesses.

b.) Quarter corner common to Sections 13 and 14. 1852 - Established by Z.B.Searles, Deputy, midway and on the Section line between Section corners 40.00 chains north and south. Set post. Sugar 8" S35°E 30 links, Sugar 8" N73°W 14 links. 1943 - Norman T. Thompson RLS notes: "OBT Sugar 8" S35°E 19.8' OK no scribing. Set Heml post. New BT Sugar 14" S59°E 18.5', New BT Sugar 12" S29°W 23.6'".

Part B: Surveyor's Report on Perpetuation, Restoration, Reestablishment, or Monumentation of Corner

a.) Sept. 25, 2017. Found a 1"ID iron pipe at record bearing and distance from the rotting stump remains of the original OBT Hemlock 12" S66°E 11 links, no markings visible. Two Celotex Corp. location posters on nearby trees face the pipe and indicate that it marks the corner position. No evidence of the Maple OBT. Accepted the pipe as a careful and faithful perpetuation of the position of the original corner and placed a yellow plastic cap "Mich DNR PS33986" in the top of it.

b.) Sept. 26, 2017. Found no evidence of the original corner nor the 1943 witnesses. Found a 1" ID pinched pipe with an 11" dia. Y.Birch, blazed 4-sides with overgrowth 4" thick, adjacent to the pipe. A Ford Motor Co. location poster on a 5" Sugar faces the pipe, 1.7' distant, and is marked to indicate the corner. The poster looks older than the Sugar, perhaps having been moved from some other tree to its present location. Distance from the pipe to corner K07 was found to be 2630.93' and the bearing of that line differs from the GLO record by less than 9 minutes of arc. I accept the pipe as the best available evidence of the position of the original corner.

Part C: Field Evidence of Perpetuation or Monumentation of Corner

a.) Found 1"ID iron pipe, placed plastic MDNR cap in the top. Set measuring nail with MDNR tag in the side of:

4" Y.Birch N48°E 11.95' in clump mrkd "1/4S NBT"
4" Sugar S73°E 3.8' do
6" Y.Birch S46°W 16.45' do
5" Sugar N64°W 7.55' do

Squared a 2" sugar N27°W 5.6' for a post
E= 7893040.785 N= 206864.804

b.) Found 1"ID pinched iron pipe.

Set measuring nail with MDNR tag in the side of:
11" Y.Birch S52°E 1.7' w/old blzs mrkd "1/4S NBT"
5" Sugar N47°E 11.95' do
3" Sugar S22°W 8.2' do
7" Y.Birch N19°W 4.3' do

E= 7893856.075 N= 207647.871

Bearings are magnetic. Coordinates are MCS83 in meters, NAD83(2011) Epoch 2010.00 datum.

Coord. Ref.=NGS PID RL0041: N= 210246.994 m. E= 7895426.985 m.

Stephan J. Szyszkoski

10/16/2017

Professional Surveyor's License No.: 33986

page 1 of 1

Prepared By: S.J. Szyszkoski for the Michigan Dept. of Natural Resources, 427 N. US41 Baraga, MI 49908