

LAND CORNER RECORDATION CERTIFICATE  
Filing Requirement of Act 74, Mich. P.A. 1970 as Amended

For corners in

Baraga (County)	Located In:	Corner Code #
1. Public Land Survey	T _____ R _____ T _____ R _____ T _____ R _____	_____
2. Property Controlling in Section	S 21 T 50N R 33W S 21 T 50N R 33W S _____ T _____ R _____	4 3 _____
3. Miscellaneous Property in Sec.	S _____ T _____ R _____ S _____ T _____ R _____	_____
4. Lot No. _____, Recorded Plat _____		
5. Private Claims		

Register of Deeds Stamp & File Number

	A	B	C	D	E	F	G	H	I	J	K	L	M
1													
2	6			5		4			3		2		1
3													
4	7			8		9			10		11		12
5													
6	18			17		16			15		14		13
7													
8	19			20		21			22		23		24
9													
10	30			29		28			27		26		25
11													
12	31			32		33			34		35		36
13													

I, Stephan J. Szyszkoski, in a field survey on 4 07/27/2011  
3 07/28/2011 do hereby state  
that under requirements of P.A. 74, Michigan P.A. of 1970, the corner points mentioned in lines 1 and 2  
above were in conformance with regulations and rules therefore as required in the current manual of survey  
instructions of the United States Department of the Interior, Bureau of Land Management or by a decree of  
a Court of Law and /or that the corner points mentioned in lines 3, 4 and 5 above were in conformance with  
the rules of the Michigan Board of Land Surveyors or by a Decree of a Court of Law; established,  
re-established, monumented, recovered, found as expressed below:

NOTE: Not more than 2 corners, all in the same town and range, may be recorded  
on this certificate.

A. Description of original monument and accessories and/or subsequent restoration:

(4-Sec. 21) Northwest 1/16 corner, Sec. 21. Not established in the original survey.

(3-Sec. 21) North 1/16 corner between Sections 20-21. Not established in the original survey.

B. Description of corner evidence found and/or method applied in restoring or reestablishing corner:

(4-Sec. 21) Established the corner at the intersection of straight lines connecting opposite 1/16  
corners. From the position for the corner, I found a "T"-iron fence post S86W 11.3' distant.

(3-Sec. 21) Established the corner midway and on the section line between Section corner 1311.67'  
north and Quarter corner 1311.67' south.

C. Description of monument for corner and accessories established to perpetuate locating the position of the corner:


(4) Set 1"IDx32" I.pipe with 4" alum. MDNR cap.  
Set measuring nail with MDNR tag in the side of:  
4" Sugar N42E 23.3' mrkd "1/16S BT"  
7" Ash S60E 15.3' do  
17" Cedar N83W 15.5' do  
18" Cedar N14W 16.1' do  
Set sq'd cedar post adjacent.  
Bearings are magnetic.

(3) Set 1"IDx32" I.pipe with 4" alum. MDNR cap.  
Set measuring nail with MDNR tag in the side of:  
8" Cherry S21E 30.5' mrkd "1/16S BT"  
6" Ash S31W 21.7' do  
17" Ash S86W 37.9' do  
10" Spruce N46W 60.1' do  
Set sq'd cedar post adjacent.  
Bearings are magnetic.

Signed by Stephan J. Szyszkoski  
Surveyor's Michigan License No. 33986

Date 10/24/2011

For the Michigan Department of Natural Resources, Forest Management Division

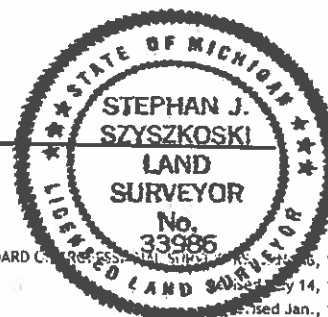

16759

16760