

MICHIGAN  
DEPARTMENT OF CONSERVATION  
FORESTRY DIVISION

# LAND CORNER RECORD

T. 50 N. R. 34-35W

Baraga COUNTY

DESCRIPTION OF CORNER Section Corner common to Sections 18-19-13-24

CORNER MONUMENT 1" Pipe with 4" Aluminum Cap


DATE MONUMENT PLACED AND WITNESSED 5-31-61

WITNESSES TO CORNER..... 8" Hard Maple (S13 NBT) N12°W 4½ links

15" Y. Birch (S24 NBT) S20°W 33½ links

5" Soft Maple (S18 NBT) N49°E 21½ links

AND

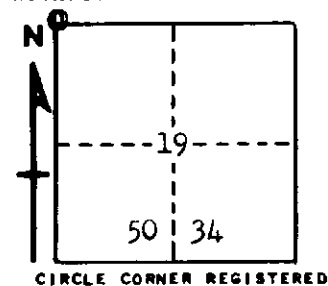

DESCRIPTION IN DETAIL AS TO HOW CORNER WAS LOCATED AND IDENTIFIED OR RESTORED.

This corner was re-established by Single Proportionate measure along township line.  
Found old squared Cedar to East of Corner.

SURVEYOR'S SEAL

SIGNED Billy D. Buckler DATE December 28, 1961  
REGISTERED LAND SURVEYOR  
Billy D. Buckler