

LAND CORNER RECORDATION CERTIFICATE  
Filing Requirement of Act 74, Mich. P.A. 1970 as Amended

For corners in

| Baraga<br>(County)                    | Located In:      | Corner Code # |
|---------------------------------------|------------------|---------------|
| 1. Public Land Survey                 | T 51N R 32W      | J9            |
|                                       | T R              |               |
|                                       | T R              |               |
| 2. Property Controlling<br>in Section | S T R            |               |
|                                       | S 26 T 51N R 32W | 5             |
|                                       | S T R            |               |
| 3. Miscellaneous<br>Property in Sec.  | S T R            |               |
|                                       | S T R            |               |
| 4. Lot No. , Recorded Plat            |                  |               |
| 5. Private Claims                     |                  |               |

Register of Deeds Stamp & File Number

|    | A  | B | C  | D | E  | F | G  | H | I  | J | K  | L | M |
|----|----|---|----|---|----|---|----|---|----|---|----|---|---|
| 1  |    |   |    |   |    |   |    |   |    |   |    |   |   |
| 2  | 6  |   | 5  |   | 4  |   | 3  |   | 2  |   | 1  |   |   |
| 3  |    |   |    |   |    |   |    |   |    |   |    |   |   |
| 4  | 7  |   | 8  |   | 9  |   | 10 |   | 11 |   | 12 |   |   |
| 5  |    |   |    |   |    |   |    |   |    |   |    |   |   |
| 6  | 18 |   | 17 |   | 16 |   | 15 |   | 14 |   | 13 |   |   |
| 8  | 19 |   | 20 |   | 21 |   | 22 |   | 23 |   | 24 |   |   |
| 9  |    |   |    |   |    |   |    |   |    |   |    |   |   |
| 10 | 30 |   | 29 |   | 28 |   | 27 |   | 26 |   | 25 |   |   |
| 11 |    |   |    |   |    |   |    |   |    |   |    |   |   |
| 12 | 31 |   | 32 |   | 33 |   | 34 |   | 35 |   | 36 |   |   |
| 13 |    |   |    |   |    |   |    |   |    |   |    |   |   |

I, Stephan J. Szyszkoski, in a field survey on J9 03/17/2011 do hereby state  
that under requirements of P.A. 74, Michigan P.A. of 1970, the corner points mentioned in lines 1 and 2  
above were in conformance with regulations and rules therefore as required in the current manual of survey  
instructions of the United States Department of the Interior, Bureau of Land Management or by a decree of  
a Court of Law and /or that the corner points mentioned in lines 3, 4 and 5 above were in conformance with  
the rules of the Michigan Board of Land Surveyors or by a Decree of a Court of Law; established,  
re-established, monumented, recovered, found as expressed below:

NOTE: Not more than 2 corners, all in the same town and range, may be recorded  
on this certificate.

A. Description of original monument and accessories and/or subsequent restoration:

(J9) Quarter corner common to Sections 23 and 26. 1986 - Reestablished by Stephen D. Douglas,  
Cadastral Surveyor, for the U.S. D.O.I., Bureau of Land Management in a dependent resurvey of this  
township. Reestablished at proportionate distance along the Section line. Set alum. post 30"x2.5"  
dia. with alum. cap, appropriately stamped. Sugar 8" N36E 17 links, Sugar 10" S08W 68 links.

(5-Sec. 26) North 1/16 corner, Section 26. Not established in the original survey.

B. Description of corner evidence found and/or method applied in restoring or reestablishing corner:

(J9) Recovered the 1986 monument as described, in good condition, and at record bearing and distance  
from the Sugar NBT S08W (S13W meas.) 68 links, in good condition. Accepted the monument as a careful  
and faithful reestablishment of the position of the original corner.

(5-Sec. 26) Established the corner midway and on a straight line between Quarter corner 1321.45'  
north and the intersection of 1/4 lines of Section 26 1321.45' south.

C. Description of monument for corner and accessories established to perpetuate locating the position of the corner:


(J9) Found 2.5" pipe with 4" alum. BLM cap.  
Set measuring nail with MDNR tag in the side of:  
10" Sugar S13W 44.8' mrkd "1/4S" 1986 NBT  
7" triple Maple N80W 16.85' mrkd "1/4S NBT"  
5" Sugar N34E 24.05' do  
7" Sugar S18E 26.50' do  
Set sq'd Cedar post adjacent.  
Bearings are magnetic.

(5) Set 1"IDx32" I.pipe with 4" alum. MDNR cap.  
Set measuring nail with MDNR tag in the side of:  
4" Sugar N03E 20.95' mrkd "1/16S BT"  
10" Sugar S60E 44.25' do  
6" Sugar S48W 15.95' do  
13" Maple N73W 25.7' do  
Set sq'd Cedar post adjacent.  
Bearings are magnetic.

Signed by Stephan J. Szyszkoski  
Surveyor's Michigan License No. 33986

Date 08/30/2011

For the Michigan Department of Natural Resources, Forest Management Division

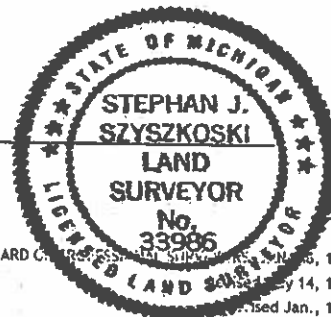

16709

16708