

APR 08 1996

COMMISSION

LAND CORNER RECORDATION CERTIFICATE

Filing Requirement of Act 74, Mich. P.A. 1970

For corners in

Baraga

(County)

Located In:

Corner Code #

1. Public Land Survey

T 51N R 32W

L-13

T R

T R

T R

T R

2. Property Controlling
in Section

S T R

S T R

3. Miscellaneous

S T R

Property in Section

S T R

4. Lot No. , Recorded Plat

5. Private Claims

RECEIVED FOR RECORD THIS 28TH DAY
OF DECEMBER A.D. 1995 AT 10:30 AM
AND RECORDED IN LIBER 4 OF LAND
CORNER RECORDATION ON PAGES
605 - 606.

Hilda J. Robillard

BARAGA COUNTY REGISTER OF DEEDS

Register of Deeds Stamp & File Number

I, Michael Mileski, in a field survey on December, 19 95,

do hereby certify that under requirements of P.A. 74, Michigan P.A. of 1970, the corner points mentioned in lines 1 and 2 above were in conformance with regulations and rules therefore as required in the current manual of survey instructions of the United States Department of the Interior, Bureau of Land Management or by a decree of a Court of Law and/or that the corner points mentioned in lines 3, 4 and 5 above were in conformance with the rules of the Michigan Board of Professional Surveyors or by a Decree of a Court of Law; established, re-established, monumented, re-monumented, recovered, found as expressed below:

NOTE: Not more than 4 corners, all in the same town and range, may be recorded on this certificate.

A. Description of original monument and accessories and/or subsequent restoration:

L-13; South One-quarter Corner Section 36, T51N, R32W, on 5th Correction Line.

See back of form.

APPROVED LAND CORNER
P.A. 345 OF 1990
Baraga County
12-19-95
[Signature]

B. Description of corner evidence found and/or method applied in restoring or reestablishing corner:


L-13; South One-quarter Corner Section 36, T51N, R32W, on 5th Correction Line.

Reestablished this corner midway and on line between standard corners immediately to the east and west.

C. Description of monument for corner and accessories established to perpetuate locating the position of the corner:

L-13; South One-quarter Corner Section 36, T51N, R32W, on 5th Correction Line.

See back of form.

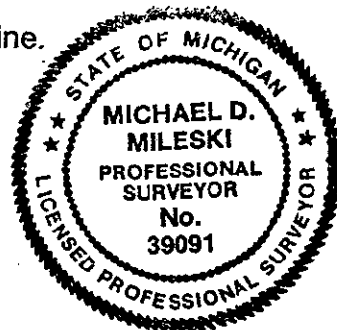

Signed by Michael Mileski

Date 28 Dec 1995

Surveyor's Michigan License No. 39091

FORM APPROVED BY MICHIGAN STATE BOARD OF PROFESSIONAL SURVEYORS, JAN. 28, 1971
REVISED MAY 14, 1975
REVISED JAN., 1983

A. Description of original monument and accessories and/or subsequent restoration:

L-13; South One-quarter Corner Section 36, T51N, R32W, on 5th Correction Line.

Originally established during U.S. Survey conducted by Austin Burt, D.S. in 1845 and monumented by a 10" dia. hemlock witnessed by a

Sugar 10 N57°E 22 lks. (Gone)

This corner was reestablished at proportionate distance between the southwest corner of Section 35, T51N, R32W and the south one-quarter corner of Section 31, T51N, R31W by Michael Avery and Stephen Douglas of the Bureau of Land Management during the course of a survey conducted from 17 September 1982 to 30 September 1983 and approved 8 July 1985. The BLM did not remonument the corner.

C. Description of monument for corner and accessories established to perpetuate locating the position of the corner:

L-13; South One-quarter Corner Section 36, T51N, R32W, on 5th Correction Line.

Set 1" (I.D.) x 36" galvanized iron pipe with 2" aluminum cap appropriately stamped as to location.

Set 60d spike	NW/side	20" Sugar Maple	N28°E	20.26'
Set 60d spike	S/side	15" Sugar Maple	S79°E	25.75'
Set 60d spike	NW/side	26" Sugar Maple	S40°W	11.91'
Set 60d spike	N/side	28" Sugar Maple	S84°W	29.16'

All of the above new bearing trees marked with upper and lower face blazes and scribed "NBT".