

AUG 05 1994

COMMISSION

LAND CORNER RECORDATION CERTIFICATE

Filing Requirement of Act 74, Mich. P.A. 1970

For corners in

Baraga

(County)

Located In:

Corner Code ##

1. Public Land Survey

T 51N R 33W

G-13 M.C.

T R

T R

T R

T R

2. Property Controlling
in Section

S T R

S T R

3. Miscellaneous

S T R

Property in Sec.

S T R

4. Lot No. , Recorded Plat

5. Private Claims

RECEIVED FOR RECORD THIS 2ND DAY
OF AUGUST, A.D. 1994 AT 9:00 A.M. AI
RECORDED IN LIBER 4 OF LAND CORNER
RECORDATION ON PAGE 484.

Dennis R. Destrampe
BARAGA COUNTY REGISTER OF DEEDS

Register of Deeds Stamp & File Number

I, Dennis R. Destrampe, in a field survey on December 17, 1993,
do hereby certify that under requirements of P.A. 74, Michigan P.A. of 1970, the corner points mentioned
in lines 1 and 2 above were in conformance with regulations and rules therefore as required in the
current manual of survey instructions of the United States Department of the Interior, Bureau of Land
Management or by a decree of a Court of Law and/or that the corner points mentioned in lines 3, 4 and 5
above were in conformance with the rules of the Michigan Board of Land Surveyors or by a Decree of a
Court of Law, established, re-established, monumented, re-monumented, recovered, found as
expressed below:

**NOTE: Not more than 4 corners, all in the same town and range, may be recorded
on this certificate.**

A. Description of original monument and accessories and/or subsequent restoration:

Post

Pine 20 N18E 11


Course of Shore S30W & N33E

Original corner not found. No record of subsequent
restoration.

B. Description of corner evidence found and/or method applied in restoring or reestablishing corner:

No evidence found of original corner or subsequent restoration. A traverse
line was run from the SW corner of Section 33 to the S $\frac{1}{4}$ corner of Section
33 and extended east to the water's edge; which, using the G.L.O.
distance, put the Meander Corner 92'± into the water. Corner was set
363.00' east of the S $\frac{1}{4}$ corner of Section 33, 90.8' from the present
water's edge. Due to being in a residential yard, monument was set
1" below ground.

APPROVED LAND CORNER
P.A. 345 OF 1990
Baraga County

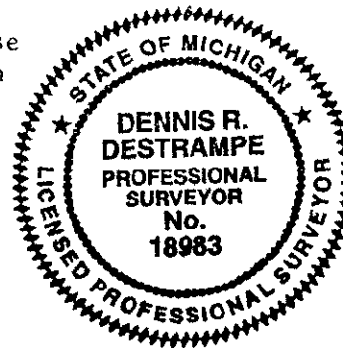

C. Description of monument for corner and accessories established to perpetuate locating the position of the corner:

Set 1"X36" pipe with 2 $\frac{1}{2}$ " brass cap 1" below ground. Baraga Cty Remonumentation brass
cap stamped:

Witnesses:

12" W. Pine N46E 41.86' (Nail & tag "UPEA 18983" set)
15" W. Pine N69E 37.14' (Nail & tag "UPEA 18983" set)
6" Aspen S04W 29.66' (Nail & tag "UPEA 18983" set)
22" Red Oak N45W 38.22' (Nail & tag "UPEA 18983" set)

T51N R33W

S33 MC

S1

T50N R34W

1994

All of the above new bearing trees are scribed "NBT".

Signed by

Dennis R. Destrampe

Date June 16, 1994

Surveyor's Michigan License No.

18983