

SURVEY &
REMONUMENTATION

BARRY COUNTY REMONUMENTATION

STATE OF MICHIGAN
COUNTY OF BARRY
REGISTER OF DEEDS

JUL 24 1997

LAND CORNER RECORDATION CERTIFICATE
Filing Requirement of Act 74, Mich. P.A. 1970

MAR 5 9 25 AM '97

COMMISSION
For corners in
BARRY
(County)

Located In: Corner Code #

1. Public Land Survey	T	2N	R	9W	J-3
1/4 CORNER COMMON TO	T		R		
SECTIONS 2 & 11	T		R		
HOPE TOWNSHIP	T		R		
2. Property Controlling	S		T	R	
in Section	S		T	R	
3. Miscellaneous	S		T	R	
Property in Sec.	S		T	R	

Sandy J. Reynolds

REGISTER OF DEEDS

002481

Register of Deeds Stamp & File Number

4. Lot No. _____, Recorded Plat _____
5. Private Claims _____

BRIAN REYNOLDS

4 SEPTEMBER

96

I, _____, in a field survey on _____, 19 _____, do hereby certify that under requirements of P.A. 74, Michigan P.A. of 1970, the corner points mentioned in lines 1 and 2 above were in conformance with regulations and rules therefore as required in the current manual of survey instructions of the United States Department of the Interior, Bureau of Land Management or by a decree of a Court of Law and/or that the corner points mentioned in lines 3, 4 and 5 above were in conformance with the rules of the Michigan Board of Land Surveyors or by a Decree of a Court of Law; established, re-established, monumented, re-monumented, recovered, found as expressed below.

NOTE: Not more than 4 corners, all in the same town and range, may be recorded on this certificate.

A. Description of original monument and accessories and/or subsequent restoration:


1. GENERAL LAND OFFICE: SYLVESTER SIBLEY, D.S., 1827 (R9W,P.73) "WEST CORRECTED 39.84" A BEECH 10 S2W 14 A MAPLE 12 N11W 31
2. COUNTY SURVEYOR RECORDS: MANCHUM (L.2,P.220) NO DATE "STONE FOR CORNER"
3. COUNTY ROAD COMMISSION: NO NAME OR DATE "IRON" 10" ASH N. 44.1' 30" ASH N50°W 51.3' 8" ASH S45°E 38.3'
4. UNRECORDED SURVEY OF PARCEL IN SW 1/4 OF SECTION 2 BY Wm. HUME ROGERS, P.S. #8197, DATED JUNE 2, 1971 "IRON AT SOUTH 1/4 POST OF SECTION 2.....TIES: NORTH 28.0 TO FACE OF ANCHOR POST NAIL 4' UP IN 3" ASH N56°W 56.70 30" ASH STUMP N50°W 51.3' 14" ASH NORTH 44.10'
5. PRIVATE NOTES FROM AN UNRECORDED SURVEY OF PARCEL IN SW 1/4 OF SECTION 2 BY BRIAN REYNOLDS, P.S. #31602, DATED MAY 13, 1993, "FOUND IRON BY ROGERS REPLACED WITH BARRY COUNTY MONUMENT N&T IN NE'LY SIDE 16" MAPLE N70W 69.14' N&T IN EAST SIDE UTILITY POLE N02W 62.82' N&T IN SE'LY SIDE 18" MAPLE N45E 68.31' N&T IN NORTH SIDE 10" E'LY TRUNK TWIN ASH S70E 61.37

B. Description of corner evidence found and/or method applied in restoring or reestablishing corner:

FOUND IRON AS DESCRIBED IN ITEMS 4 AND 5 OF PART "A." ACCEPTED AS BEST EVIDENCE AVAILABLE FOR CORNER POSITION.

REPLACED FOUND IRON WITH STANDARD BARRY COUNTY REMONUMENTATION MONUMENT

ACT 345 BARRY COUNTY REMONUMENTATION
APPROVED BY PEER REVIEW AT A MEETING HELD ON
9-9-'96
BRIAN REYNOLDS
COUNTY SURVEYOR

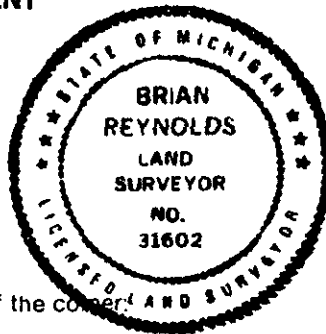

C. Description of monument for corner and accessories established to perpetuate locating the position of the corner:

SET STANDARD BARRY COUNTY REMONUMENTATION MONUMENT (WITH ALUMINUM CAP)
SET 20d NAIL W/REMON TAG IN THE NORTHEAST SIDE OF A 16" MAPLE N70°W 69.14'
SET 20d NAIL W/REMON TAG IN THE EAST SIDE OF A UTILITY POLE N2°W 62.68'
SET 20d NAIL W/REMON TAG IN THE SOUTHEAST SIDE OF AN 18" MAPLE N45°E 68.31
SET 20d NAIL W/REMON TAG IN THE NORTH SIDE OF A 10" EASTERLY TRUNK OF A TWIN ASH S70°E 61.37'
CORNER LIES ON THE CENTERLINE OF AN EAST-WEST BITUMINOUS ROADWAY
IN LINE WITH A FENCE RUNNING NORTH

Signed by Brian Reynolds Date FEB 18, 1997

Surveyor's Michigan License No. 31602