

JUL 24 1997

COMMISSION

BARRY COUNTY REMONUMENTATION

LAND CORNER RECORDATION CERTIFICATE
Filing Requirement of Act 74, Mich. P.A. 1970

For Corners in BARRY Located In: Corner Code #
(county)

1. Public Land Survey T 3N R 7W C-13
CORNER COMMON TO T R
SECTIONS 31 & 32 T R
CASTLETON TOWNSHIP T R
ON TOWNSHIP LINE
2. Property Controlling S T R
in Section S T R
3. Miscellaneous S T R
Property in Sec. S T R
4. Lot No , Recorded Plat
5. Private Claims

STATE OF MICHIGAN
BARRY COUNTY
RECORDED

17 JUN 97 12:20 P.M.

SAMUEL SCHONDELMEYER
REGISTER OF DEEDS

002502

Register of Deeds Stamp & File Number

I, **Brian Reynolds**, in a field survey on **21 JANUARY, 1997** do hereby certify that under requirements of P.A. 74, Michigan P.A. of 1970, the corner points mentioned in lines 1 and 2 above were in conformance with regulations and rules therefore as required in the current manual of survey instructions of the United States Department of the Interior, Bureau of Land Management or by a decree of a Court of Law and/or that the corner points mentioned in lines 3, 4, and 5 above were in conformance with the rules of the Michigan Board of Land Surveyors or by a Decree of a Court of Law; established, re-established, monumented, re-monumented, recovered, found as expressed below.

A	B	C	D	E	F	G	H	I	J	K	L	M
2	6	5	4	3	2	1						
3												
4	7	8	9	10	11	12						
5												
6	18	17	16	15	14	13						
7												
8	19	20	21	22	23	24						
9												
10	30	29	28	27	26	25						
11												
12	31	32	33	34	35	36						
13												

NOTE: Not more than 2 corners, all in the same town and range, may be recorded on this certificate.

A. Description of original monument and accessories and/or subsequent restoration:

- GENERAL LAND OFFICE: L. LYON, D.S., 1825 OR 1826, (R7W, P.86) BEECH 7 N77 1/2E 30 Do. 14 N65 1/2W 44
- COUNTY SURVEYOR RECORDS: A.C. WILLSON, APRIL 1879, (L.1, P.280) "STAKE STONE & BRICK"
A STAKE STONE & BRICK STANDING N45°W 50 Do. STANDING N45°E 50
- COUNTY ROAD COMMISSION: "FOUND IRON, SET BOAT SPIKE ON TOP" (BARRYVILLE ROAD F.B., PAGE 2) 37" CLUMP OF ELM N78°W 41.58'
10" CLUMP OF ELM S27°E 48.67' 8" ELM N23°E 60.87'
- ALSO: 3/8" IRON ROD NAIL IN 9" ELM N23°E 60.47' NAIL IN 37" CLUMP OF ELM N78°W 42.35' NAIL IN 10" ELM S27°E 49.27'
- MICH. HIGHWAY DEPT.: "FOUND 3/8" IRON ROD. RAISED WITH 1 1/4" PIPE" 29" ASH N15°E 94.11' COR. FC. POST E. 31.20' P. POLE N85°W 68.56'
- LAND CORNER RECORDATION CERTIFICATE: #76 BY Wm. HUME ROGERS, P.S. #6197, APRIL 1973,
M.S.H. TAG IN 29" ASH STUMP N15°E 94.11' FENCE POST E. 31.2' POWER POLE N85°W 68.56'
- ALSO: L.C.R.C. #179, BY JAMES L. KING, P.S. #14766, JUNE 1974, 1 1/4" PIPE BROUGHT TO SURFACE WITH 1/2" IRON
UTILITY POLE N85°W 68.51' 18" BOX ELDER N15°E 112.04' IN LINE WITH FENCE EAST 1.5' WEST OF CENTERLINE OF NORTH-SOUTH ROAD
- ACT 132 SURVEY: BY Wm. HUME ROGERS, P.S. #6197, 1973, (L.1, P.113) RECITE SAME WITNESSES AS IN L.C.R.C. #76 ABOVE
- ACT 132 SURVEY: BY JAMES L. KING, P.S. #14766, 1974, (L.1, P.229-234) RECITE SAME WITNESSES AS IN L.C.R.C. #179 ABOVE

B. Description of corner evidence found and/or method applied in restoring or reestablishing corner:

FOUND 1/2" IRON ROD 1.5' WEST OF THE CENTERLINE OF NORTH-SOUTH BITUMINOUS ROADWAY. FOUND WITNESSES BY ROGERS (ITEM #6 ABOVE) ASH STUMP MISSING. FOUND ALL WITNESSES FROM #7, #8, & #9 ABOVE. 18" BOX ELDER (#7 ABOVE) IS NOW A 24" (ASH) NAIL OVERGROWN. FOUND 1/2" IRON CONFORMS VERY WELL WITH CORRESPONDING CORNERS AND OCCUPATION THROUGHOUT SECTION.
ACCEPTED FOUND 1/2" IRON AS BEST AVAILABLE EVIDENCE OF CORNER POSITION.
REPLACED FOUND 1/2" IRON WITH STANDARD BARRY COUNTY REMONUMENTATION MONUMENT.

C. Description of monument for corner and accessories established to perpetuate locating the position of the corner:

SET STANDARD BARRY COUNTY REMONUMENTATION MONUMENT (3/4" X 36" IRON) WITH ALUMINUM CAP.
FOUND NAIL W/WASHER IN THE SOUTH SIDE OF A UTILITY POLE N88°W 68.54'
SET 20d NAIL W/REMON TAG IN THE SOUTH SIDE OF A WOODEN CORNER POST N89°W 33.13'
SET 20d NAIL W/REMON TAG IN THE NORTHEAST SIDE OF AN 8" ASH N48°W 38.98'
SET 20d NAIL W/REMON TAG IN THE NORTHEAST SIDE/NORTHERN TRUNK OF AN 18" TWIN ASH N15°W 107.77'
SET 20d NAIL W/REMON TAG IN THE WEST SIDE OF A 24" ASH N12°E 111.94'
CORNER IS IN LINE WITH A FENCE LINE RUNNING EAST & 1.5' WEST OF CENTERLINE


ACT 345 BARRY COUNTY REMONUMENTATION
APPROVED BY PEER REVIEW AT A MEETING HELD ON

3-11-'96

BRIAN REYNOLDS

BR

COUNTY SURVEYOR

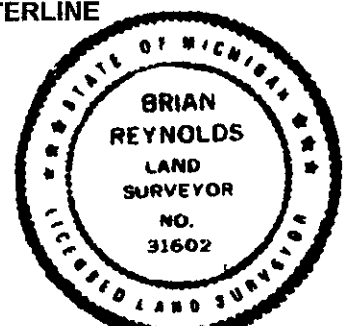

Signed by

Surveyor's Michigan License No 31602

Date

MAY 16, 1997