

SURVEY &  
REMONUMENTATION

MAY 20 1997

COMMISSION

BARRY COUNTY REMONUMENTATION  
LAND CORNER RECORDATION CERTIFICATE  
Filing Requirement of Act 74, Mich. P.A. 1970

STATE OF MICHIGAN  
COUNTY BARRY  
RECEIVED

DEC 9 2 09 PM '96

Sandy Schmalzmaier

REGISTER OF DEEDS

002424

Register of Deeds Stamp & File Number

For corners in

BARRY

(County)

Located in:

Corner Code #

1. Public Land Survey	T 3	R 7	E-2
1/4 COR COMMON TO	T	R	
SEC'S 4 & 5	T	R	
CASTLETON TWP.	T	R	
2. Property Controlling	S	T	R
in Section	S	T	R
3. Miscellaneous	S	T	R
Property in Sec.	S	T	R

4. Lot No. \_\_\_\_\_, Recorded Plat \_\_\_\_\_  
5. Private Claims \_\_\_\_\_

I, RAYMOND MOORED, in a field survey on MAY, 19 95 do hereby state that under requirements of P.A. 74, Michigan P.A. of 1970, the corner points mentioned in lines 1 and 2 above were in conformance with regulations and rules therefore as required in the current manual of survey instructions of the United States Department of the Interior, Bureau of Land Management or by a decree of a Court of Law and for that the corner points mentioned in lines 3, 4 and 5 above were in conformance with the rules of the Michigan Board of Land Surveyors or by a Decree of a Court of Law; established, re-established, monumented, recovered, found as expressed below:

NOTE: Not more than 2 corners, all in the same town and range, may be recorded on this certificate.

	A	B	C	D	E	F	G	H	I	J	K	L	M
1													
2		6		5	4		3		2		1		
3													
4		7		8		9		10		11		12	
5													
6		18		17		16		15		14		13	
7													
8		19		20		21		22		23		24	
9													
10		30		29		28		27		26		25	
11													
12		31		32		33		34		35		36	
13													

A. Description of original monument and accessories and/or subsequent restoration:

SYLVESTER SIBLEY D.S. 1830 (R7W, P. 112) A BEECH 7 S. 89 1/2 W.  
25 DO. 26. N36W 16. CSR CHERRY 8 N 42 1/2 W 2.80 STAKE & STONE  
SETH PRATT L.2,P. 222. SUGAR 6 S 34 3/4 E 1.45 24-25 AUG. 1881  
SET POST BEARINGS DECAYED A.D. RORK JUNE 20, 1886 (L.2, P.105

B. Description of corner evidence found and/or method applied in restoring or reestablishing corner:

COULDN'T LOCATE CORNER. SET STANDARD BARRY COUNTY REMON IRON W/CAP ON LINE BETWEEN E-1 AND E-3 ON OCCUPATION LINES EAST & WEST. ACCEPTED AS BEST AVAILABLE EVIDENCE OF CORNER LOCATION. SET STANDARD BARRY COUNTY REMON IRON W/CAP.

C. Description of monument for corner and accessories established to perpetuate locating the position of the corner:


STANDARD BARRY COUNTY REMON IRON W/CAP  
-CENTER OF STEEL FENCE POST WEST 27.77'  
-CENTER OF STEEL FENCE POST EAST 26.22'  
-NAIL & TAG N SIDE 40" WALNUT S85DEG. E 29.05'  
-NAIL & TAG S SIDE 24" WALNUT WEST 132.88'

ACT 345 BARRY COUNTY REMONUMENTATION  
APPROVED BY PEER REVIEW AT A MEETING HELD ON

13 NOV. '95

BRIAN REYNOLDS

COUNTY SURVEYOR

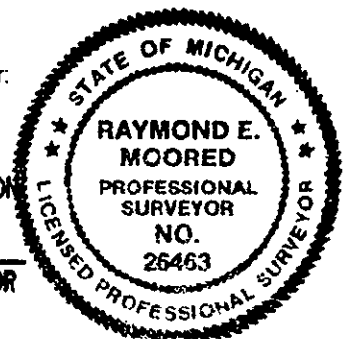

Signed by

*Raymond Moored*

Date

12/2/96

Surveyor's Michigan License No.

26463