

LAND CORNER RECORDATION CERTIFICATE

FILING REQUIREMENT OF ACT 74, MICH. P.A.1970

FOR CORNERS OF--	LOCATED IN--	CORNER CODE NUMBER
1. PUBLIC LAND SURVEY.....	T. 25 N. R. 13 W.	L-7; L-8; L-9
2. PROPERTY CONTROLLING IN SECTION.....	T. N. S. R. E. W.	
3. MISCELLANEOUS PROPERTY IN SECTION.....	T. N. S. R. E. W.	
4. LOT NO., RECORDED PLAT.....		
5. PRIVATE CLAIMS.....		

REGISTER OF DEEDS STAMP AND FILING NUMBER

I, Carl F. Roser, do hereby certify that under requirements of P.A. 74, Michigan P.A. of 1970, the corner points mentioned in lines 1 and 2 above were, in a field survey on November 20, 1980, established, re-established, monumented, re-monumented, recovered or restored as expressed below and in conformance with regulations and rules therefore as required in the current manual of survey instructions of the United States Department of the Interior, Bureau of Land Management or by a decree of a court of law. Furthermore, that the corner points mentioned in lines 3, 4 and 5 above were, in a field survey on, 19...., found, recovered, restored, established or re-established as expressed below and in conformance with the rules of the Michigan State Board of Registration for Land Surveyors or, by a Decree of a Court of law:

XX
C. Continued: L-9


Fd 1 3/4" pipe that fits 3-Act 74
Wits & Set Ced. Post w/loc Tag.
6" Maple N40°W 11.59
6" Maple S60°W 20.18
8" Basswood S65°E 6.33
6" Maple N65°E 23.7

B. Description of corner evidence found and/or method applied in restoring or re-establishing corner:

- L-7 Re-established N 1/4 Cor. of Sec.24 on line across fd.Ctr. & So. 1/4 Cor. & at Rec. Haswell Dist. N. from Ctr. Sec.24. See F. Haswell Sec.24, Sub'n, Feb. 1894, Liber "0" Pg. 136.
- L-8 Fd & accepted 1 1/4" pipe for Ctr. of Sec.24, F.S. Haswell set 1 1/4" pipe at inter. of 1/4 lines in 1894 survey, See Sec.24 Sub'n, Liber "0", Pg. 136.
- L-9 Accepted fd 1 3/4" pipe at SWly corner of Cor. fn. post remains for S 1/4 Cor. Sec. 24. Old B. Wire fn, mostly down, is N-E-W. Fd another 1 3/4" pipe & piece of Cross Cut Saw N25°E 1.00' at other side of post hole remains. Corner fits old Survey's of Record S-24, E.S. Haswell Feb. 1894, Liber "0" Pg. 136; S-25, G. Langford, 1900+ Liber "0" Pg. 46

C. Description of monument for corner and accessories established to perpetuate locating the position of the corner:

L-7	L-8
Set DNR Mon & Ced. Post	Fd 1 1/4" pipe; drove 5/8"x36" re-rod
6" Cedar S80°E 5.5	in pipe & set Ced. Post w/loc Tag
8" Cedar N43°W 10.2	7" Hemlock N40°E 17.1
16" Maple N03°E 14.1	7" Maple N35°W 23.5
	10" Hemlock N40°W 49.5
	6" Hemlock S10°W 24.0
	Ctr. B.Top Rd. East 304'±

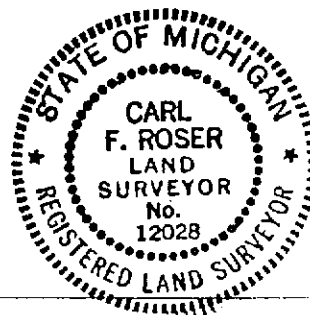

SIGNED BY Carl F. Roser 3-31-81 DATE

SURVEYOR'S MICHIGAN REGISTRATION NO. 12028

(SEAL)

FOR STATE AND UNITED STATES AGENCIES:

SIGNED BY _____ DATE _____

CHIEF OF SURVEY PARTY

APPROVED AND SIGNED BY _____ DATE _____

MICHIGAN REGISTERED LAND SURVEYOR

(SEAL)

SURVEYOR'S MICHIGAN REGISTRATION NO.

Colfax Township
BENZIE COUNTY