

Land Corner Recordation Certificate
Authority: 1970 PA 74, MCL 54.205


Surveyor's Name: Craig W. McVean Field Survey Date: Dec. 1, 2016
For corner(s) in: Benzie County

Original Public Land Survey Corner
S T R
S T R
S T R
S T R

Property Controlling Corner
S T R
S T R
S T R
S T R

Property Corner
S 14 T 25N R 14W 15
S 14, 15 T 36N R 14W SS 1/64
S T R
S T R

Protracted Public Land Survey Corner
S T R
S T R
S T R
S T R

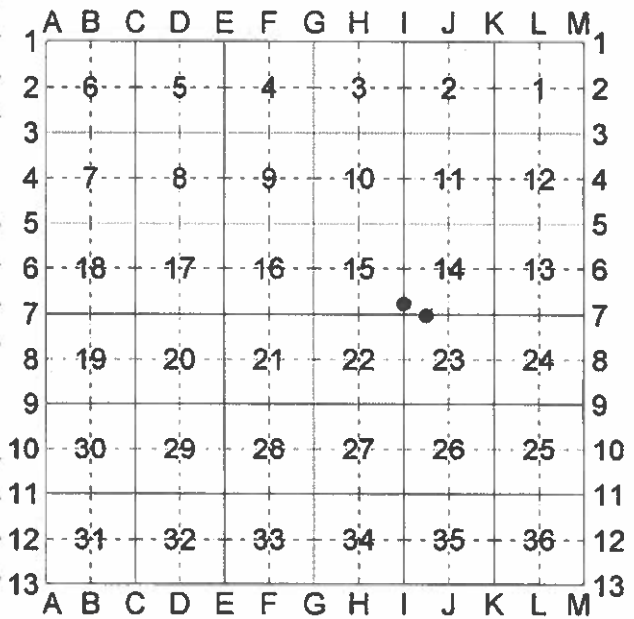

Part A: Corner History

15 - W 1/16 Corner common to Section 14 & 23, T25N, R14W - None
SS 1/64 - Corner common to Sec. 14 & 15 being the SW corner of the N 1/2 of the SW 1/4 of the SW 1/4 Sec. 14, T25N, R14W - None

**Part B: Surveyor's Report on Perpetuation, Restoration, Reestablishment, or Monumentation of Corner**

**15** – W 1/16 Corner common to Sec. 14 & 15, T25N, R14W – Set 2" Alum. Cap on 5/8" x 34" long iron rebar per standard BLM procedure. 1' S. of physical centerline E-W gravel road.

**SS 1/64** – corner common to Sec. 14 & 15 and being the SW corner of the N ½ of the SW ¼ of the SW ¼ of Sec. 14, T25N, R14W - Set 2" Alum. Cap on 5/8" x 34" long iron rebar per standard BLM procedure. Physical centerline of N-S Sand road is 1' East.

**Part C: Field Evidence of Perpetuation or Monumentation of Corner**

**15** – W 1/16 corner common to Sec. 14 & 15, T25N, R14W – Stamped 2" Aluminum cap on 5/8" x 34" long iron rebar – Down 0.5'.  
North 33.00' to set 2" Alum. Cap on 5/8" x 34" long rebar on line with Blue Composite Post with loc. tag.  
S47°E 47.05' to set N & T in SW side 18" R. Pine  
S08°E 35.58' to set N & T in E. side 22" W. Pine  
S52°W 54.67' to set N & T in SE side 11" R. Maple

**SS 1/64** – corner common to Sec. 14 & 15 and being the SW Corner of the N ½ of the SW ¼ of the SW ¼ of Sec. 14, T25N, R14W - Stamped 2" Aluminum Cap on 5/8" x 34" long iron rebar  
East 33.00' to set 2" Alum. Cap on 5/8" x 34" long iron rebar on line with Blue Composite Post with loc. tag.  
S36°W 69.07' to set N & T in SE side 11" R. Pine  
S82°W 43.60' to set N & T in N. side 12" R. Pine  
N32°E 80.43' to set N & T in W. side 17" W. Pine

*Craig W. McVean*

Craig W. McVean

*1/25/2017*

Date

Professional Surveyor's License No.: 39088

Prepared By:

Craig W. McVean  
Michigan Dept. of Natural Resources  
8015 Mackinaw Trail  
Cadillac, Michigan 49601

