

# LAND CORNER RECORDATION CERTIFICATE

Filing Requirement of Act 74, Mich. PA 1970

For Corners In:

Benzie

Located In

Corner Code #

(County)

1. Public Land Survey		T	<u>25N</u>	R	<u>14W</u>	<u>J10</u>
		T		R		
2. Property Controlling in Section	S	<u>26</u>	T	<u>25N</u>	R	<u>14W</u>
	S		T		R	
3. Miscellaneous Property in Section	S		T		R	
	S		T		R	

4. Lot No: \_\_\_\_\_ Recorded Plat: \_\_\_\_\_

5. Private Claims: \_\_\_\_\_

I, Craig W. McVean, in a field survey on January 8, 2003 do hereby state that under requirements of PA 74, Michigan PA of 1970, the corner points mentioned in lines 1 and 2 above were in conformance with regulations and rules therefore as required in the current manual of survey instructions of the United States Department of the Interior, Bureau of Land Management or by a decree of a Court of Law and/or that the corner points mentioned in lines 3, 4 and 5 above were in conformance with the rules of the Michigan Board of Land Surveyors or by a Decree of a Court of Law; established, re-established, monumented, recovered, found as expressed below:

**NOTE: Not more than 2 corners, all in the same town and range, may be recorded on this certificate.**


Register of Deeds Stamp & File Number

	A	B	C	D	E	F	G	H	I	J	K	L	M
1													
2	6		5		4		3		2		1		
3													
4	7		8		9		10		11		12		
5													
6	18		17		16		15		14		13		
7													
8	19		20		21		22		23		24		
9													
10	30		29		28		27		26		25		
11													
12	31		32		33		34		35		36		
13													

A. Description of original monument and accessories and/or subsequent restoration:

J10 - None

9 - None

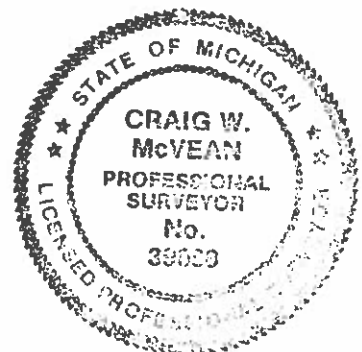

B. Description of corner evidence found and/or method applies in restoring or re-establishing corner:

J10 - C1/4, Sec. 26 - Set 2" Aluminum Cap (Stamped) on 5/8" x 34" Rebar at intersection of 1/4 Line per Standard BLM procedure. Edge of Swamp is 80' ± 20' North.

9 - CE 1/16 Cor., Sec. 26 - Set 2" Aluminum Cap (stamped) on 5/8" x 34" Rebar per standard BLM procedure.

C. Description of monument for corner and accessories established to perpetuate locating the position of the corner:

J10 - 2" AC on 5/8" x 34" Rebar  
SW 1' to Set Blue Carsonite Post with location tag.  
S84°W 28.98' to set N&T in N side 10" Hemlock  
N13°E 30.60' to set N&T in E side 5" Beech scribed 'XBT'  
N61°E 42.89' to set N&T in N side 4" Beech scribed 'XBT'  
S4°E 42.53' to set N&T in W side 14" Hemlock

9 - 2" AC on 5/8" x 34" Rebar  
SE 1' to set Blue Carsonite Post with location tag  
N20°E 13.31' to set N&T in NW side 11" Tamerack  
N73°E 28.27' to set N&T in NW side 12" Tamerack  
S57°E 12.07' to set N&T in NE side 8" R. Maple  
S12°W 6.05' to set N&T in W side 6" R. Maple

Signed by:

Craig W. McVean

Date:

1/27/2003

Surveyor's Michigan License No.:

39088